

CENTRAL MAPPING AUTHORITY
Department of Lands

Trigonometrical Survey of N.S.W.

RECONNAISSANCE and MAINTENANCE REPORT

STATION **WATTALL** T.S. **10546**

This Trig. Station has been:-

Note: Cross out word or words which do not apply

1. ~~Completely cleared to permit 360° vision to surrounding Trig.~~
2. Cleared by lanes bearing as per station diagram from Trig. Mast
3. Trig. Mast & Vanes have been painted white ~~as per station diagram~~
4. The Trig. was unpiled/not unpiled, dimensions now being: ~~Original Station Mast~~
Description of mark... Concrete Pillar should be explicit, e.g. Steel plug, Brass plug, Bolt, G.I. Pipe
Height of mark... 1.38 m above rock/concrete ~~below G.L.~~ Diameter of Vanes (vertical) 0.60 m.

Height of ~~Cross~~ ... m. Diameter of ~~Cross~~ ... m.

Length of Mast ... m. (approximate if not unpiled)

5. A. set in conc/rock has been placed ... m. bearing ...°M from Trig. Mast
6. A. set in conc/soil has been placed ... m. bearing ...°M from Trig. Mast
7. A. set in conc/soil has been placed ... m. bearing ...°M from Trig. Mast
8. A. set in conc/rock has been placed ... m. bearing ...°M from Trig. Mast

9. Connection ... to ... m. bearing ...°M

10. Connection ... to ... m. bearing ...°M

11. Connection ... to ... m. bearing ...°M

12. Connection ... to ... m. bearing ...°M

13. Diff. Ht. is ... m. ^{above}/_{below}

14. Diff. Ht. is ... m. ^{above}/_{below}

15. Diff. Ht. is ... m. ^{above}/_{below}

16. Diff. Ht. is ... m. ^{above}/_{below}

Prepared by: B.H.P. SURVEY DEPT.

Noted on U.T.M. Card

Checked

Co: **CAMDEN** Ph: **CORDEAUX**

Map Sheet: **BULLI** No: **9029-II-N**

Inspected by: **S.M.E.C.** Date:


Authority: **S.M.E.C.** Field Book:

Beacon Diagram 0.1 Not to Scale

0.60

0.88

1.38

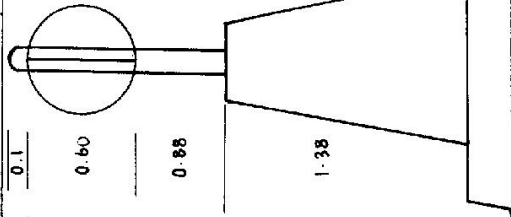

Date


Record of Station
Pillar erected on 27-11-77 by B.H.P.

STATION WATTALLI (P) T.S. 10546

Owners Name: **M.W.S. & D.B.**
 Current Occupant:
 Address: **SYDNEY**
 Address:

Not to Scale

Station Diagram

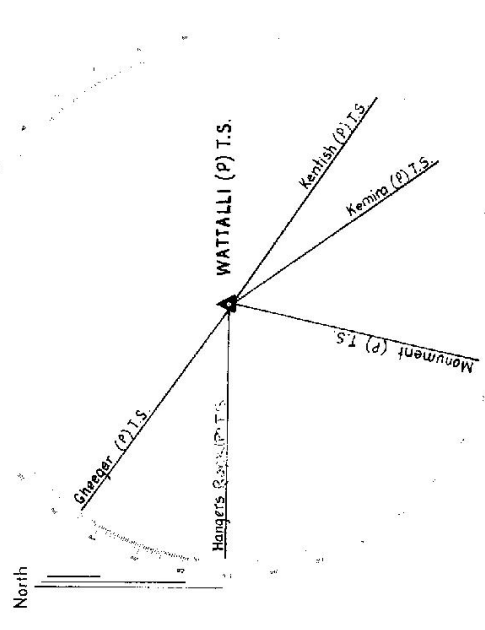


List of Observed Directions:-

Station	Direction	Station	Direction
Kentish Pillar	359° 59' 60"		
Kemira Pillar	19° 52' 56"		
Monument Pillar	68° 52' 25"		
Hangers Rock Pillar	147° 49' 51"		
Gheeger Pillar	184° 12' 12"		
Station	Direction	Station	Direction

Access

LOCALITY SKETCH

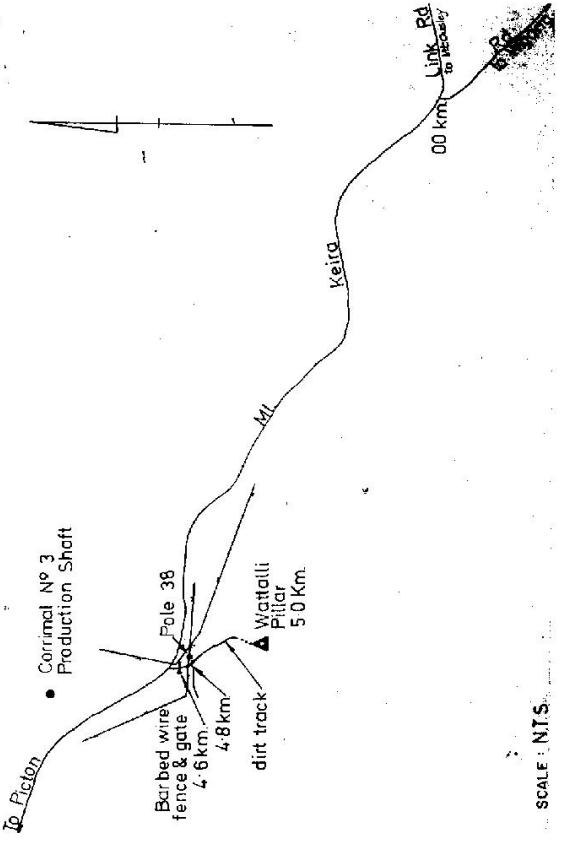

SCALE: N.T.S.