

STATION TS INVINCIBLE (P)


TS 10548

Owners Name..... Current Occupant.....

Address.....

Access 16-4-1978 Entrance to Invincible Celliery on
00km WITTON - MUDGE RD.
HEAD SOUTH.
1-3 Turn left onto Track (Fire trail)
3-8 TS on left.
short walk 5mins
AWD to base of rock.

Station Diagram Not to Scale

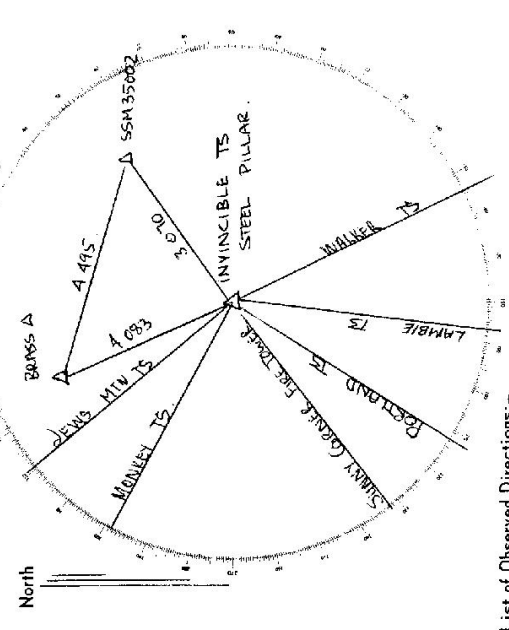

List of Observed Directions:-

Standpoint: PILLAR		Standpoint:	
Station	Direction	Station	Direction
PORTLAND TS	214° 00' 00"	LAMBIE TS	186° 05' 56"
SUNNY CORNER F.T.	232° 51' 30"	BRASS A	336° 41' 30"
MANLEY TS	248° 34' 54"	SSM 35 002	573° 05' 53"
JEWIS MTN TS	320° 00' 00"		
WALKER TS	1573° 31' 04"		
Station	Direction	Station	Direction