

LAND INFORMATION CENTRE

GEODETTIC SURVEY OF A.S.M.

GEODETTIC STATION, RECONNAISSANCE and MAINTENANCE REPORT

Description:

1. Cleared by Janes bearing.  $38^{\circ} - 164^{\circ}$   $185^{\circ} - 219^{\circ}$   $224^{\circ} - 238^{\circ}$   
Note: Cross out words or words which do not apply  
 Vanes  $305^{\circ} \times 313^{\circ}$  from Trig. Mast
2. Mast & Vanes have been painted white & black respectively.
3. The station/pillar was unpiled/not unpiled/constructed on.....19..... dimensions now being:

Description of mark.....should be explicit, e.g., S/Steel Pillar Plate, Steel plug, Brass plug, Bolt, G.I. Pipe

Height of mark.....m. above rock/concrete: Mark is.....m. above G.L.  
 Height of Top Vanes to Top Mark/Pillar plate.....m. Diameter of Vanes (vertical).....m.

Height of Cairn.....m. Diameter of Cairn.....m. Name Plate found/not found/placed.  
 Length of Mast.....m. (approximate if not unpiled)

4. A.....set in conc/rock has been placed/found, bearing..... $^{\circ}$ M. from Mast/Plug/Pillar
5. A.....set in conc/rock has been placed/found, bearing..... $^{\circ}$ M. from Mast/Plug/Pillar
6. A.....set in conc/rock has been placed/found, bearing..... $^{\circ}$ M. from Mast/Plug/Pillar
7. A.....set in conc/rock has been placed/found, bearing..... $^{\circ}$ M. from Mast/Plug/Pillar

8. Action required:.....

STANDPOINT:


Mark	Direction	Horiz. Distance	Height Difference	Mark	Direction	Horiz. Distance	Height Difference
			above standpt.				above standpt.
			below standpt.				below standpt.
			above standpt.				above standpt.
			below standpt.				below standpt.
Prepared by: *[Signature]* 4/3/93

Checked: U.T.M. Carl

S: 2733-1

STATION: CARPENTERS (P) TS No.: 10550  
 MAP SHEET SCALE 1:250 000 (GLEN INNES)  
 INSPECTED BY: G. FORD  
 AUTHORITY: L. I. C. DATE: 19-2-93  
 FIELD BOOK: -

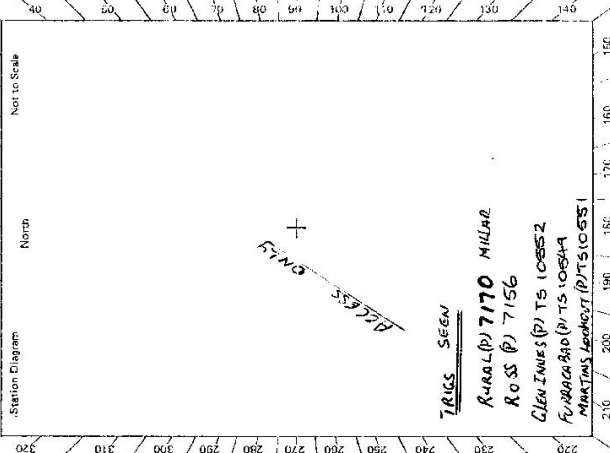

Checked:

STATION **CARPENTERS (P) TS 10550**

---

Owner's Name: **MRS L. A. CREEGAN** Current Occupant: .....

Address: **103 CHURCH ST** Address: .....

**GLEN INNES** Phone: .....

**32 3181** Phone: .....

**(DAUGHTER'S SHOP 333010)** Phone: .....

ACCESS

Access Report of **19.2.1993** was found suitable/unsuitable.

---

0.00	P.O. GLEN INNES GRAY ST / MEADE ST NORTH ALONG GRAY ST.
0.16	TURN LEFT ONTO GWYDIR A.W.Y. TOWARDS INNERELL
1.02	RAIL WAY CROSSING.
4.22	TURN RIGHT SIGN ABBOTTS ROAD
5.9	" LEFT
6.15	END OF ROAD VEER RIGHT ONTO TRACK
6.17	LOCKED GATE C.M.A. LOCK
6.69	GATE
6.78	TV TOWERS MAKE OWN WAY TO SOUTHERN END OF HILL
7.51	CARPENTERS TRIG.

---

Date	Record of Station

---

Not to Scale

Not to Scale

---

This section to be completed by officer constructing pillar.

Original station mark found/not found.

Description of mark: .....

Original beacon found/not found.

Description of beacon: .....

Height Top of Vanes to Top Mark.....m.

Height of mark.....m. above rock/conc.....m. below G.L.

Diameter of Vanes.....m. Height of Cairn.....m.

Original Beacon has/has not been destroyed by me.