

7-5-193

Department of Lands **RECONNAISSANCE and MAINTENANCE REPORT** **STATION TS 10558 ABATTOIR LPJ**

Integrati... Jivey of N.S.W.


This Trig. Station has been:-

Note: Cross out word or words which do not apply

1. ~~Completely cleared to permit 360° vision to surrounding trig.~~
2. Cleared by lanes bearing $175^{\circ} 34' N, 45^{\circ} 10' E, 150^{\circ} N, 160^{\circ} M$ from Trig. Mast
3. Trig. Mast & Vanes have been painted white & black respectively.
4. The Trig. was unpiled/not unpiled, dimensions now being:
Description of mark... **CONCRETE OBSERVING PILLAR**, should be explicit, e.g. Steel plug, Brass plug, Bat, Concrete Pillar
Height of mark... 1.77 m ^{above} ~~concrete~~ _{below} 1.4 m ^{above} G.L.
- Height of Top Vanes to Top Mast Top pillar plate... 1.47 m Diameter of Vanes (vertical)... 0.60 m.
- Height of Cairn... ~~.....~~ Diameter of Cairn... ~~.....~~
- Length of Mast... 1.56 m. (approximate if not unpiled)
5. A ~~SSM 2500~~ set in conc./~~soil~~ has been placed/~~fd~~ 7.610 m. bearing 17° ⁰M from Trig. Mast/pillar
6. A ~~Copper Spike~~ set in conc./~~soil~~ has been placed/~~fd~~ 6.409 m. bearing 317° ⁰M from Trig. Mast/pillar
7. A... set in conc./soil has been placed/~~fd~~... m. bearing... ⁰M from Trig. Mast/pillar
8. A... set in conc./rock has been placed/~~fd~~... m. bearing... ⁰M from Trig. Mast/pillar
9. Connection... ~~SSM~~ to... ~~CS~~... 6.754 m. bearing... 246 ⁰M
10. Connection... to... to... m. bearing... ⁰M
11. Connection... to... to... m. bearing... ⁰M
12. Connection... to... to... m. bearing... ⁰M
13. Diff. Ht. ... ~~SSM 2500~~ is 1.545 m. ^{above} ~~below~~ Pillar
14. Diff. Ht. ... ~~Copper Spike~~ is 1.545 m. ^{above} ~~below~~ Pillar
15. Diff. Ht. ... is... m. ^{above} ~~below~~
16. Diff. Ht. ... is... m. ^{above} ~~below~~

Map Sheet: **GUYRA** No: **9257**
 Inspected by: **E. J. GARVIN** Date: **21. 7. 78**
 Authority: **INTEGRATION** Field Book: **1124**

Beacon Diagram Not to Scale

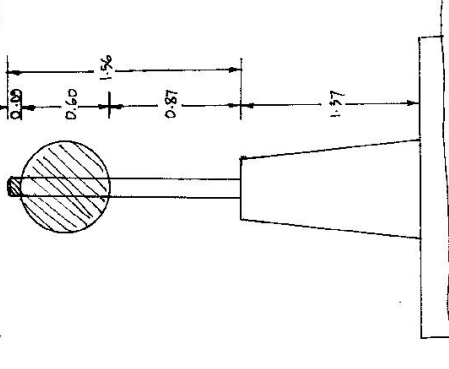

Date	Record of Station
20.6.79	PILLAR REJECTED - I. CARTER

Prepared by: **E. J. GARVIN T-5.** Checked: **.....**

STATION TS 10558 ABATTOIR [P]

Current Occupant.....

Address.....


Owners Name: New England Regional Abattoir

Address.....

Access 21-7-78


N

 NOT TO SCALE

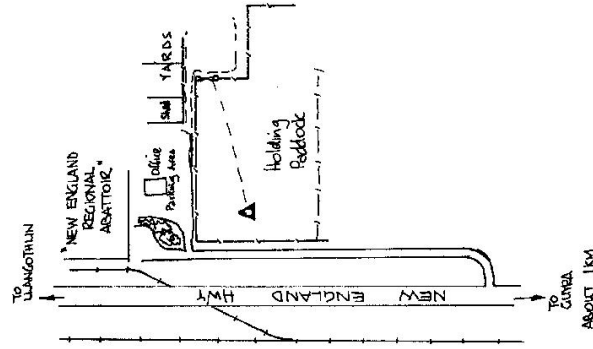

D. West, Government Printer, New South Wales - 1976

Not to Scale

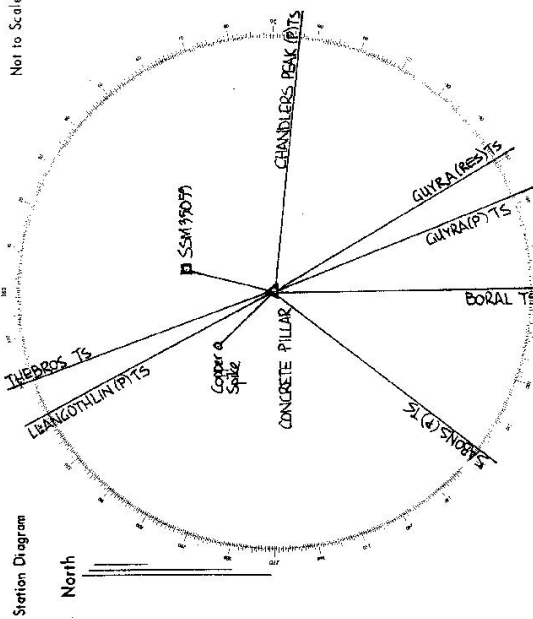

List of Observed Directions:-

Standpoint: Concrete Pillar

Station	Direction	Station	Direction
TS 2870 LANGOITHLIN (P)	332° 00' 00"		
TS 4934 THEBROS	340° 34' 39"		
TS 1151 CHANDLERS PEAK (P)	96° 54' 02.5"		
TS 10957 GUYRA (RES)	147° 21' 28.0"		
TS 7288 GUYRA (P)	198° 11' 46.5"		
TS 1087 BORAL	174° 01' 43.0"		
TS 10960 SARBENS (P)	217° 45' 31.7"		
SSM 37509	12° 45' 14.5"		
Copper Spike	316° 30' 24.8"		