

Department of Lands Integrating survey of N.S.W

**RECONNAISSANCE and MAINTENANCE REPORT**

STATION **TS 10559** **GUYRA RES (P)**  
 Co: **SANDON** Ph: **FALCONER**  
 Map Sheet: **GUYRA** No: **9297**  
 Inspected by: **E. J. GARVIN** Date: **24.7.78**  
 Authority: **INTEGRATION** Field Book: **1124**

This Trig. Station has been: Beacon Diagram

1. Completely cleared to permit 360° vision to surrounding Trigs.
2. ~~Cleared by fumes bearing~~ ..... from Trig. Mast
3. Trig. Mast & Vanes have been painted white & black respectively.
4. The Trig. was unpiled/not unpiled, dimensions now being:  
 Description of mark: **STEEL OBSERVING PILLAR** should be explicit, e.g. Steel plug, Brass plug, Balr, Concrete Pillar  
 Height of mark:  $1.41$  m above rock, concrete about  $17$  m above G.L.  
 Height of Top Vanes to Top Mast/Top pillar plate:  $1.16$  m Diameter of Vanes (vertical)  $0.60$  m.


~~Height of Coin~~ ..... m. Diameter of Coin ..... m.

- Length of Mast  $1.55$  m. (approximate if not unpiled)
5. A ..... set in conc./rock has been placed/fd ..... m. bearing .....°M from Trig. Mast/pillar
  6. A ..... set in conc./soil has been placed/fd ..... m. bearing .....°M from Trig. Mast/pillar
  7. A ..... set in conc./soil has been placed/fd ..... m. bearing .....°M from Trig. Mast/pillar
  8. A ..... set in conc./rock has been placed/fd ..... m. bearing .....°M from Trig. Mast/pillar

9. Connection ..... to ..... m. bearing .....°M
10. Connection ..... to ..... m. bearing .....°M
11. Connection ..... to ..... m. bearing .....°M
12. Connection ..... to ..... m. bearing .....°M
13. Diff. Ht. .... is ..... m. above below
14. Diff. Ht. .... is ..... m. above below
15. Diff. Ht. .... is ..... m. above below
16. Diff. Ht. .... is ..... m. above below

Prepared by: **E. J. GARVIN** T.S. Checked: \_\_\_\_\_

Not to Scale

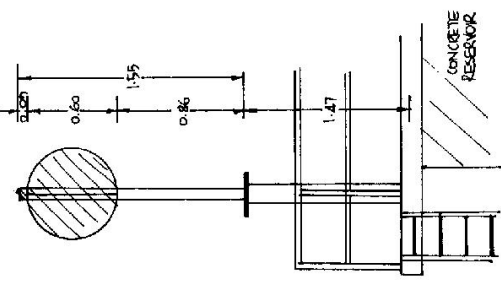

Date	Record of Station
15.7.78	PILLAR ERECTED - J. CARTER

STATION TS10559 GUYRA RES (P)

Owners Name... Guyra, Shiraz, Cousins

Current Occupant.....


Address..... Cousins Chambers.....

Address.....

..... Guyra


Access 2A-7-1978

Not to Scale

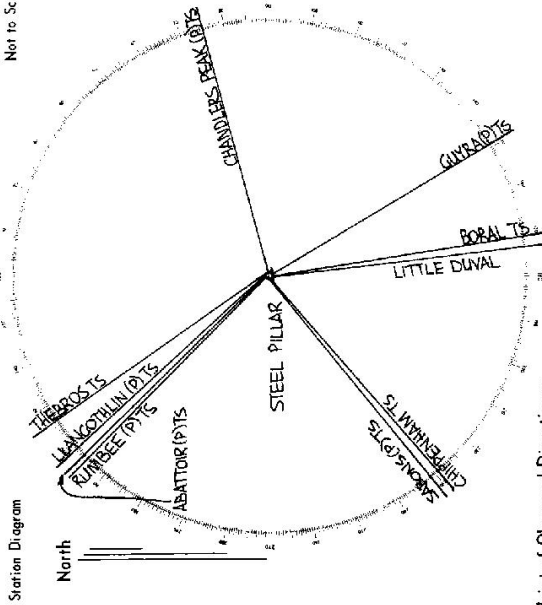

List of Observed Directions:-

Station		Standpoint: Steel Pillar		Station	
Station	Direction	Station	Direction	Station	Direction
TS 11451 CHAMBERS PEAK (P)	157° 00' 00"	THEBROS TS			
TS 2988 GUYRA (P)	148° 58' 22.5"	LUANGOTHUN (P) TS			
TS 1007 BORAL	170° 46' 19.1"	RUBREE (P) TS			
TS 2898 LITTLE DUVAL	172° 11' 10.2"	ABATOR (P) TS			
TS 1112 CHIPPERRAM	227° 01' 12.1"	STEEL PILLAR			
		CHAMBERS PEAK (P) TS			
		GUYRA (P) TS			
		BORAL TS			
		LITTLE DUVAL			
		CHIPPERRAM TS			
Station		Direction		Station	
Station	Direction	Station	Direction	Station	Direction
TS 1080 SABONS (P)	230° 50' 54.2"				
TS 2275 RUMBEE (P)	311° 56' 28.9"				
TS 10398 ABATOR (P)	315° 59' 48.4"				
TS 2870 LUANGOTHUN (P)	318° 05' 14.7"				
TS 4336 THEBROS	325° 55' 14.5"				

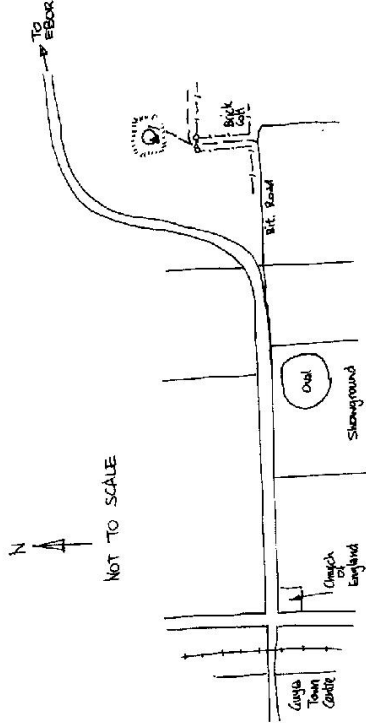

D. West, Government Printer, New South Wales - 1976