

LAND INFORMATION CENTRE

GEODETTIC SURVEY OF N.S.W.

GEODETTIC STATION RECONNAISSANCE and MAINTENANCE REPORT

STATION: **BYUMA PILLAR** No.: **10565**

MAP SHEET SCALE 1:250 000


INSPECTED BY: **D. J. KAIN** DATE: **21 2 91**

AUTHORITY: **L.I.C.** FIELD BOOK: **G11**

Description:

Note: Cross out word or words which do not apply

1. Cleared by lanes bearing. **No obstructions. clear in elevation** from Trig. Mast  
**FOR G.P.S. TYPE SURVEY**
2. Mast & Vanes have been painted white & black respectively.  
**INSPECTED**
3. The station/pillar was ~~unplaced/not placed/constructed~~ on **21 8** 19**91**, dimensions now being:  
**Steel Pillar Plate** should be explicit, e.g., S/Steel Pillar Plate, Steel plug, Brass plug, Bolt, G.I. Pipe  
Height of mark **1.370** above ~~rock~~ **concrete**; Mark is **1.370** above ~~below~~ **G.L.**  
Height of Top Vanes to Top ~~mark~~ **Pillar plate** **1.370** m. Diameter of Vanes (vertical) **0.595** m.  
Height of Cairn **1.510** m. Diameter of Cairn **1.370** m. Name Plate found/~~not found~~/placed, **BYUMA T.S.**  
Length of Mast **1.510** m. (~~approximate if not supplied~~)  
4. A. **No satellite marks found.** set in conc/rock has been placed/found; bearing **.....** ° M from Mast/Plug/Pillar  
5. A. **.....** set in conc/rock has been placed/found; bearing **.....** ° M from Mast/Plug/Pillar  
6. A. **.....** set in conc/rock has been placed/found; bearing **.....** ° M from Mast/Plug/Pillar  
7. A. **.....** set in conc/rock has been placed/found; bearing **.....** ° M from Mast/Plug/Pillar  
8. Action required: **.....**

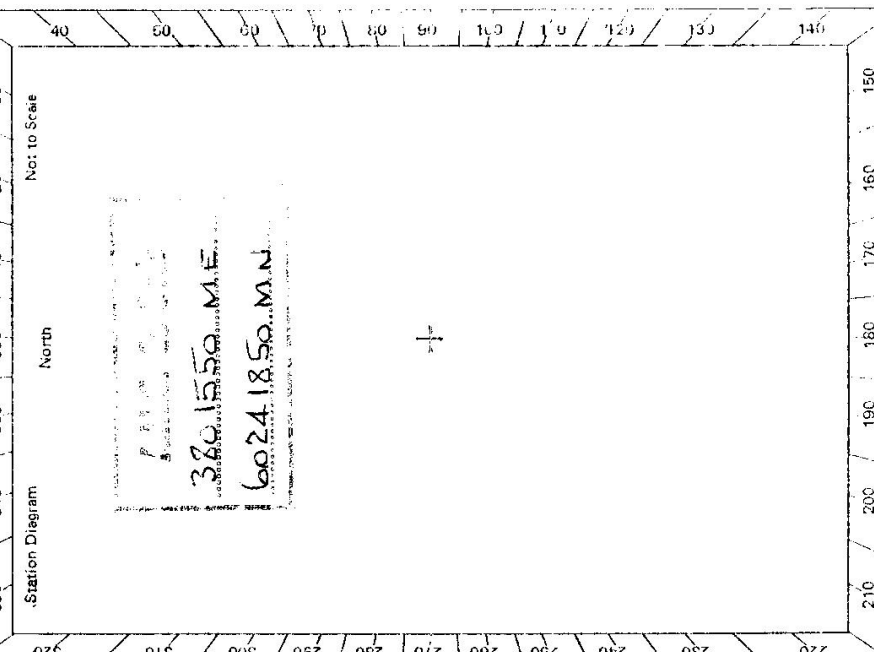

STANDPOINT:

Mark	Direction	Horiz. Distance	Height Difference	Mark	Direction	Horiz. Distance	Height Difference
			above standpt.				above standpt.
			below				below
			above standpt.				above standpt.
			below				below

Prepared by: **D. KAIN** Checked: **.....** Noted on U.T.M. Card

STATION **BUYUMA Concrete Pillar 10565**

Owner's Name: **BERRIGAN SHIRE Council** Current Occupant: .....  
 Address: **CHAMBER STREET, BERRIGAN, 2712.** Address: .....  
 Phone: **(058) 852003** Shire Phone: .....  
 Contact: **John Diamond Engineer. ACCESS**

Access Report of **1/1/78** was found suitable/unsuitable. **21-8-91**

- KMS.**
- 0.00 **FEATURE..**
  - 0.32 **BAROOGA POST OFFICE, TRAVEL NORTH EAST**
  - 0.94 **ALONG VERMONT STREET.**
  - 1.05 **TURN LEFT INTO, BANKER STREET.**
  - 1.16 **TURN RIGHT INTO, BURKINSHAW STREET.**
  - 1.32 **TURN LEFT THROUGH DOUBLE IRON MESH GATES**
  - 1.42 **AND INTO BAROOGA RECREATIONAL RESERVE.**
  - 1.47 **PASS TENNIS COURTS AND TRACK ON YOUR LEFT,**
  - TRAVEL ALONG TRACK BETWEEN TWO OVALS.**
  - TAKE LEFT FAINT TRACK AND TRAVEL TOWARDS**
  - REAR OF TOILET FACILITIES.**
  - THROUGH IRON GATE and INTO Paddock**
  - BAROOGA PONY CLUB, TURN RIGHT ALONG FENCE.**
  - BUYUMA Concrete Pillar.**

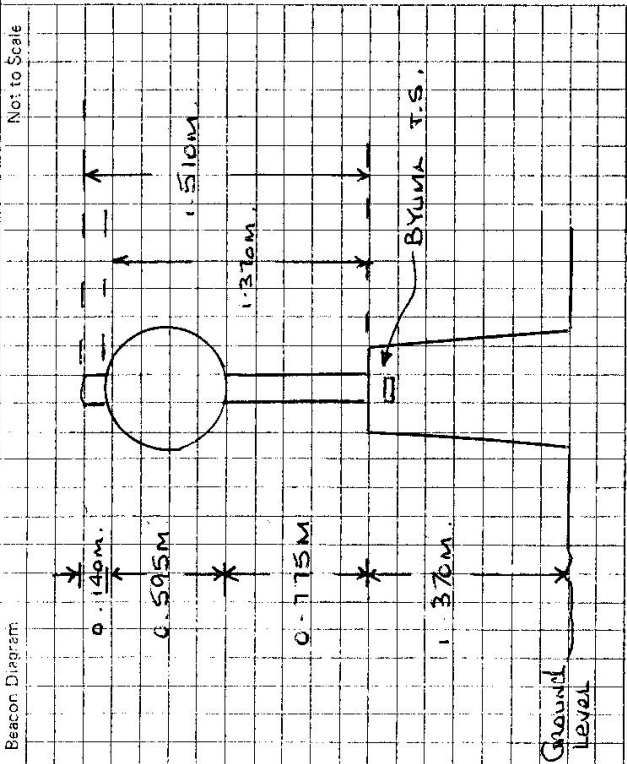

This section to be completed by officer constructing pillar.

Original station mark found/not found.

Description of mark: .....

Original beacon found/not found.

Description of beacon: .....

Height Top of Vanes to Top Mark.....m.

Height of mark.....m. above rock/conc.....m. below G.L.

Diameter of Vanes.....m. Height of Cairn.....m.

Original Beacon has/not been destroyed by me.

Date	Record of Station