

75 10

Department of Lands
Integral Survey of N.S.W.
RECONNAISSANCE and MAINTENANCE REPORT

This Trig. Station has been:- Note. Cross out word or words which do not apply

- 1. Completely cleared to permit 360° vision to surrounding Trig.
- 2. Cleared by fanes bearing..... from Trig. Mast
- 3. Trig. Mast & Vanes have been painted white & black respectively.
- 4. The Trig. was unpiled/not unpiled, dimensions now being:

Description of mark..... CONCRETE PILLAR..... should be explicit, e.g. Steel plug, Brass plug, Bolt, Concrete Pillar
 Height of mark..... 1.78 m above rock concrete 1.5 m above G.L.
 Height of Top Vanes to Top Mark/Top pillar plate..... 1.477 m Diameter of Vanes (vertical)..... 0.60 m.

Height of Cairn..... m. Diameter of Cairn..... m.

Length of Mast..... 1.55 m. (approximate if not supplied)

- 5. A. P.M. 452952 set in conc./rock has been placed/d..... 134 m bearing..... 174 m from Trig. Mast/pillar
- 6. A.P.M. 452953 set in conc./rock has been placed/d..... 250 m bearing..... 250 m from Trig. Mast/pillar
- 7. A..... set in conc./soil has been placed/d..... m. bearing..... m from Trig. Mast/pillar
- 8. A..... set in conc./rock has been placed/d..... m. bearing..... m from Trig. Mast/pillar

9. Connection P.M. to C.B..... 19.854 m. bearing..... 288 m

10. Connection..... to..... m. bearing..... m

11. Connection..... to..... m. bearing..... m

12. Connection..... to..... m. bearing..... m

13. Diff. Ht. P.M. 452953 is 1.204 m above Pillar below

14. Diff. Ht. Conc. Block is 2.194 m above Pillar below


15. Diff. Ht. is..... m. above below

16. Diff. Ht. is..... m. above below

Prepared by: E.J. CARVIN T.S. Checked.....

STATION TS 10581 COCKBURN LP
 Co: INGLIS Ph: BENDEMEER
 Map Sheet: BENDEMEER No: 2136
 Inspected by: E.J. CARVIN Date: 2.8.78
 Authority: INTEGRATION Field Book: 1124

Beacon Diagram Not to Scale

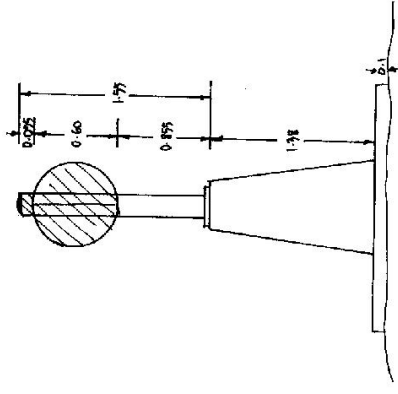

Date	Record of Station
21.11.78	PILLAR ERECTED - I. CARTER

STATION TS10581 COCKBURN [P]

Current Occupant.....

Address.....


Owners Name.....

Address.....

Access 2-8-1978

Station Diagram Not to Scale

North

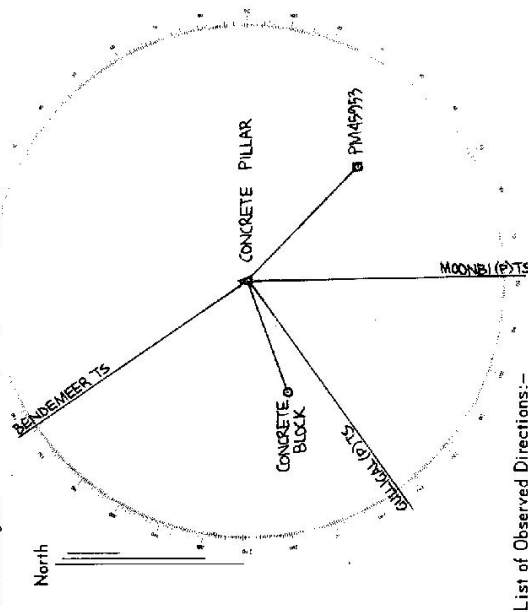

List of Observed Directions:-

Standpoint: Concrete Pillar

Station	Direction	Station	Direction
TS 3479 MOONBI (P)	179° 00' 00"		
TS 10581 CHALLICK (P)	234° 45' 45"		
TS 857 PENNYMEER CONC. BLOCK	326° 09' 00"		
TS 421 BULLAL (PTS)	249° 42' 58"		
TS 421 PENNYMEER CONC. BLOCK	130° 19' 11"		

