


7-5-19-3

STATION IS 10586 GENOA (P)  
 Co: HUNTER Ph: LEMINGTON  
 Map Sheet: HOWES VALLEY No: 9072  
 Inspected by: P McNEIL Date: 14-1-78  
 Authority ISD - NCLC Field Book: 2071129

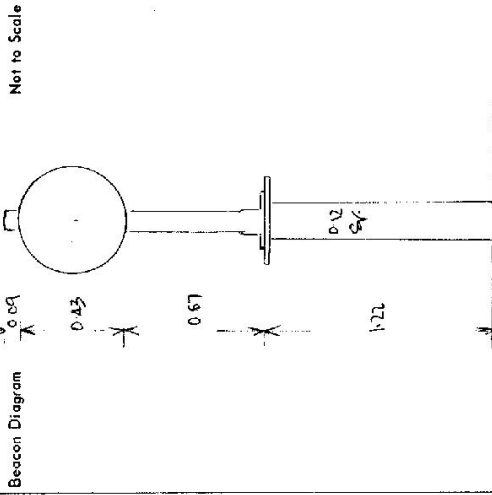

Date	Record of Station
14/1/78	Willow Erected

Department of Lands  
 Reconnaissance and Maintenance Report

This Trig. Station has been: Note. Cross out word or words which do not apply

1. Completely cleared to permit 360° vision to surrounding Trigs. ✓
2. Cleared by lances-bearing from Trig-Mast

3. Trig. Mast & Vanes have been painted white & black respectively. ✓  
 4. The Trig. was unpiled/~~re-erected~~, dimensions now being:

Description of mark steel pillar should be explicit, e.g. Steel plug, Brass plug, Belt, Concrete Pillar  
 Height of mark   m. <sup>above</sup> ~~rock-concrete~~   m. <sup>below</sup> G.L.  
 Height of Top Vanes to Top-Mark/Top pillar plate 1.39 m. Diameter of Vanes (vertical) 0.43 m.

Height of Cairn 1.22 m. Diameter of Cairn 0.12 m.  
 Length of Mast 1.39 m. (approximate if not unpiled)

5. A 550/18487 set in conc/~~rock~~ has been placed 44 15.337 m. bearing 169 °M from Trig. Mast/pillar
6. A 6.5 set in conc/~~rock~~ has been placed 44 15.437 m. bearing 191 °M from Trig. Mast/pillar
7. A   set in conc./soil has been placed/fd   m. bearing   °M from Trig. Mast/pillar
8. A   set in conc./rock has been placed/fd   m. bearing   °M from Trig. Mast/pillar

9. Connection 550/18487 to 6.5 5.977 m. bearing 269 °M
10. Connection   to   m. bearing   °M
11. Connection   to   m. bearing   °M

12. Connection   to   m. bearing   °M
13. Diff. Ht. Pillar Plate is 1.909 m. <sup>above</sup> 550/18487
14. Diff. Ht. Pillar Plate is 1.870 m. <sup>above</sup> 6.5
15. Diff. Ht. 550/18487 is 0.081 m. <sup>above</sup> 6.5
16. Diff. Ht.   is   m. <sup>above</sup>

Prepared by   Checked:


STATION TS 10586 GENDA (P)

Owners Name... Wamba Mining Current Occupant... Owner

Address... Warkworth Address.....

- km Access 14-7-1978  
 0.0 Singleton P.O. - travel South along Rutty Road.  
 11.85 Overpass (Entrance to Industrial Substation)  
 12.0 Turn right - sign "Dunman - Jerrys Plains"  
 20.95 Pass turn off on left to Bulga + Broke  
 22.25 Bridge  
 22.55 Turn left at Golden Fleece Service Stn.  
 24.75 Turn right through iron gate.  
 25.85 Grid.  
 27.30 Take left track  
 27.70 Take track to RHS of water tanks  
 27.8 Trng.

keep by conventional vehicle

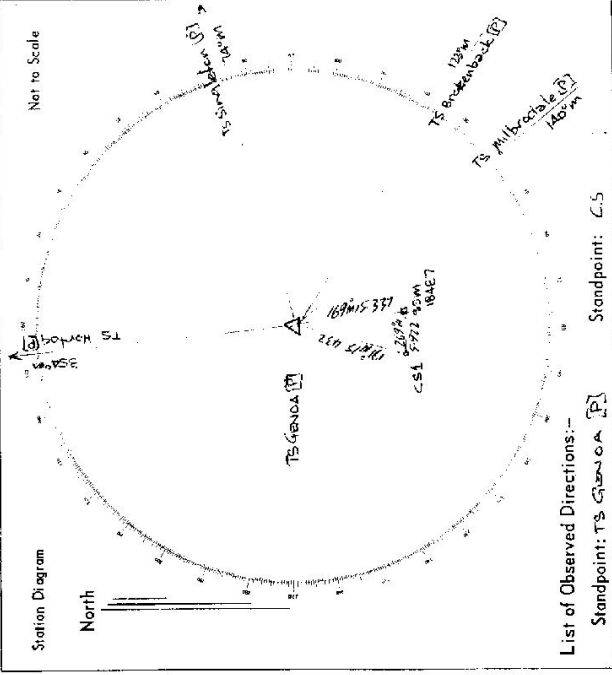

List of Observed Directions:-

Station	Direction	Station	Direction
TS Broke (P)	0° 00' 00.00"	TS Broke (P)	0° 00' 00.00"
TS Singleton (P)	77° 35' 48.37"	TS Genda (P)	17° 13' 16.5"
TS Milbrook (P)	10° 31' 12.17"	SUM 18487	97° 13' 16.5"
TS Broke Brook (P)	127° 04' 04.42"		
TS Milbrook (P)	147° 14' 13.50"		

Station	Direction	Station	Direction
SUM 18487	17° 26' 35.5"		
Copper Spike	197° 40' 34"		