


STATION TS 10587 WILKINSON (P)

Owners Name..... Current Occupant.....

Address..... Address.....

Access 14-11-1978
 FROM SWANSEA
 00 Kms
 Feature
 Swanssea Police Stn Take Pacific Hwy south towards Sydney
 4.35 Turn left off Hwy at Scenic Dr towards Mawson
 4.40 Turn left onto gravel track
 4.80 Twin lookouts & Trig

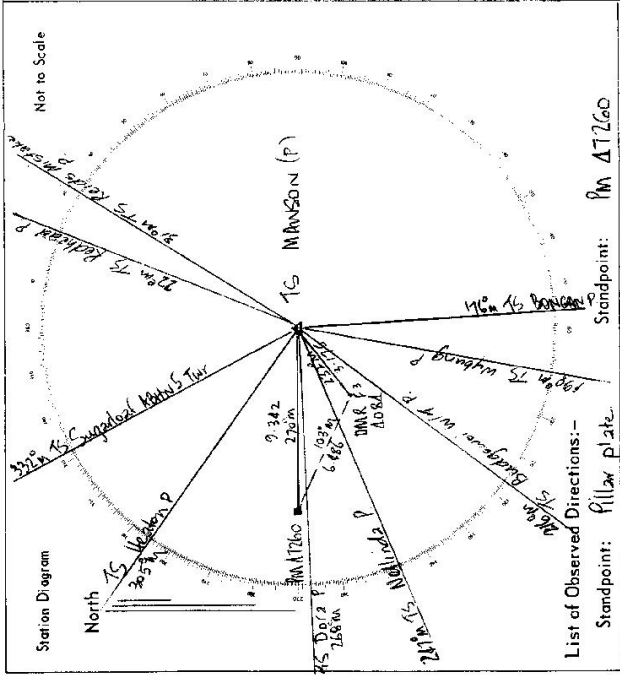

List of Observed Directions:-
 Standpoint: Pillar plate
 Standpoint: PM 47260

Station	Direction	Station	Direction
TS BANGANG P	0° 00' 00"	TS BANGANG P	0° 00' 00"
TS BANGANG P	1° 50' 40.15"	Pillar plate	270° 43' 41.5"
TS BUDGET W.P.	34° 41' 03.5"	DMR F3 AORA	204° 03' 10.5"
DMR F3 AORA	67° 10' 10"		
TS NELLANDA P	67° 51' 31.0"		
TS DORA P	65° 53' 37.83"		
PM 47260	40° 38' 46.5"		
TS HEATH P	174° 53' 30.5"		
TS SUPERIOR KRN S.M.	149° 15' 13.6"		
TS REDHEAD P	204° 33' 41.0"		
Reds Mistake P.	212° 08' 53.05"		