


STATION TS 110590 Koolewong

Owners Name Within Brisbane Water National Park Current Occupant

Address

- 6-7-1978
 Feature
 0-0 Gosford West Shopping Centre - Travel Briefly Highway to waste Station.
 3-6 Turn Left Again Way Way
 5-6 Turn Left into Bambara Rd
 6-6 Take right fork
 7-2 Straight ahead
 7-5 Looked Gate - Key from Gosford Shire Council
 9-5 ~~Looked~~ Take left fork
 9-6 Water tank and trig.

for known to tank Key Required from Gosford Shire Council.

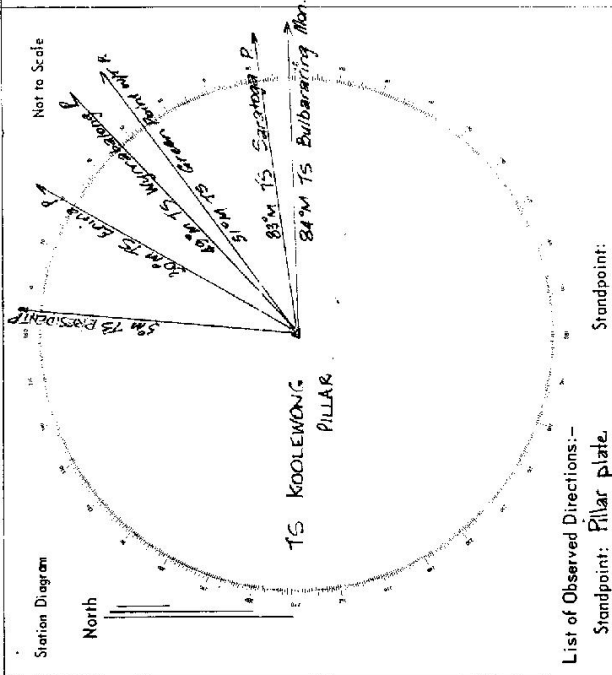

List of Observed Directions:-

Standpoint: Pillar plate		Standpoint:	
Station	Direction	Station	Direction
TS PRESIDENT P	0° 00' 00"		
TS ERINA	25° 09' 53.91"		
TS WARRABONG P	43° 54' 06.42"		
TS Green R Mt P	46° 35' 38.59"		
Station	Direction	Station	Direction
TS Sarsotoga P	78° 20' 27.43"		
TS Bulbararing Mon	79° 16' 51.00"		