

STATION **SKULLION (P) IS 10593**

Co: Northumberland Ph: Kingumber  
 Map Sheet: No:  
 Inspected by: **A.J. GREEN** Date: **13-11-76**  
 Authority: **DEPT LANDS** Field Book:

This Trig. Station has been:- Note: Cross out word or words which do not apply


1. Completely cleared to permit 360° vision to surrounding Trigs.
2. Cleared by lanes bearing. **Clear** from Trig. Mast
3. Trig. Mast & Vanes have been painted white & black respectively. ✓
4. The Trig. was unpiled/not unpiled, dimensions now being:

Description of mark **Concrete Pillar** should be explicit, e.g. Steel plug, Brass plug, Bolt, Concrete Pillar  
 Height of mark **1.37** m above ~~rock~~ **rock**/concrete ..... m above below G.L.  
 Height of Top Vanes to ~~Top pillar plate~~ **Top pillar plate** **1.27** m Diameter of Vanes (vertical) **160** m.  
 Height of Cairn ..... m. Diameter of Cairn ..... m.

Length of Mast ..... m. (approximate if not unpiled)  
 5. **A.C.I.P.** set in ~~concrete~~ **rock** has been placed/td **6.573** m. bearing **283**°M from ~~Trig. Mast~~ **Mast**/pillar  
 6. **A.** set in conc./soil has been placed/td ..... m. bearing .....°M from Trig. Mast/pillar  
 7. **A.** set in conc./soil has been placed/td ..... m. bearing .....°M from Trig. Mast/pillar  
 8. **A.** set in conc./rock has been placed/td ..... m. bearing .....°M from Trig. Mast/pillar

9. Connection ..... to ..... m. bearing .....°M **ON PILLAR**  
 10. Connection ..... to ..... m. bearing .....°M **SLAPS TO C.I.P.**  
 11. Connection ..... to ..... m. bearing .....°M **13 72 715**  
 12. Connection ..... to ..... m. bearing .....°M **246 52.2 359 59.4**  
 13. Diff. Ht. **Gal PIPE** is **2.60** m. **below** **Pillar Plate**  
 14. Diff. Ht. is ..... m. **above** **HEIGHT 1 - 21**  
 15. Diff. Ht. is ..... m. **above** **HEIGHT 1 1-52**  
 16. Diff. Ht. is ..... m. **above** **HEIGHT ABOVE PILLAR 0.36**

Prepared by: **W. J. ...** Checked: **W. J. ...**

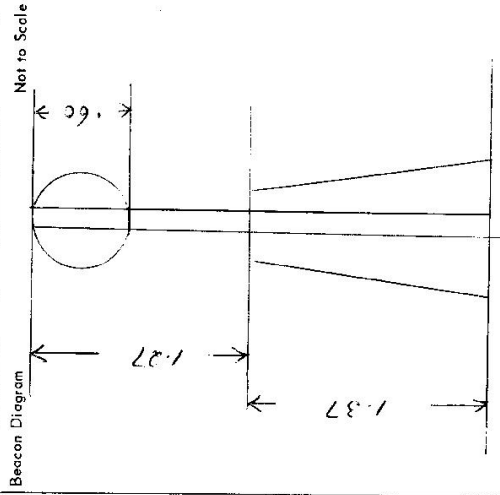

Date	Record of Station
13-11-76	N.S.W. DEPT. LANDS Ph: Kingumber



75-103

Department of Lands Integrative Survey of N.S.W.  
**RECONNAISSANCE and MAINTENANCE REPORT**


STATION **TS 10593 SKILLON (P)**

This Trig. Station has been:-

Note: Cross out word or words which do not apply

1. Completely cleared to permit 360° vision to surrounding Trigs. ✓
2. Cleared by James-bearing ✓
3. Trig. Mast & Vanes have been painted white & black respectively. ✓
4. The Trig. was unpiled/~~re-erected~~, dimensions now being:
  - Description of mark: Concrete Pillar should be explicit, e.g. Steel plug, Brass plug, Brkr, Concrete Pillar
  - Height of mark: 1.35 m above rock/concrete 1.35 m below G.L.
  - Height of Top Vanes to ~~Top Mast~~ Top pillar plate 1.35 m Diameter of Vanes (vertical) 0.60 m.
  - Height of Cairn 1.35 m. Diameter of Cairn 38 x 55 m.
  - Length of Mast 1.47 m. (approximate if not unpiled)
5. A S.I.P. 1 set in ~~concrete~~ concrete has been placed/d 6.573 m, bearing 290°M from Trig. Mast/pillar
6. A S.I.P. 2 set in ~~conc./soil~~ conc./soil has been placed/d 4.995 m, bearing 347°M from Trig. Mast/pillar
7. A          set in ~~conc./soil~~          m, bearing         °M from Trig. Mast/pillar
8. A          set in ~~conc./rock~~          m, bearing         °M from Trig. Mast/pillar
9. Connection: S.I.P. 1 to S.I.P. 2 : 5.256 m, bearing 67°M
10. Connection:          to          :          m, bearing         °M
11. Connection:          to          :          m, bearing         °M
12. Connection:          to          :          m, bearing         °M
13. Diff. Ht. Pillar Plate is 2.623 m <sup>above</sup> G.P. 1
14. Diff. Ht. Pillar Plate is 2.078 m <sup>above</sup> G.P. 2
15. Diff. Ht. G.P. 1 is 0.546 m <sup>above</sup> G.P. 2
16. Diff. Ht.          is          m <sup>above</sup>

Co: **Northumberland** | Ph: **Kincumber**  
 Map Sheet: **Gosford** | No: **9131**  
 Inspected by: **P. W. Heath** | Date: **8.1.76**  
 Authority: **ISD NICLE** | Field Book: **PP 952**

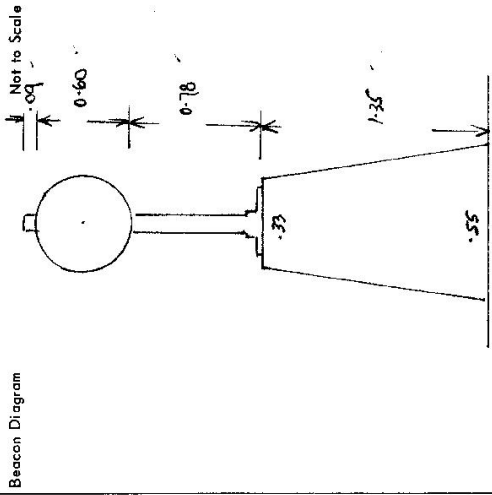

Date	Record of Station
19/1/76	Pillar Erected.

Prepared by: S.P.A. Checked: S.P.A.


STATION TS 10593 SKILLION (F)

Owners Name Gosford Shire Council

Address Gosford


Current Occupant

Address

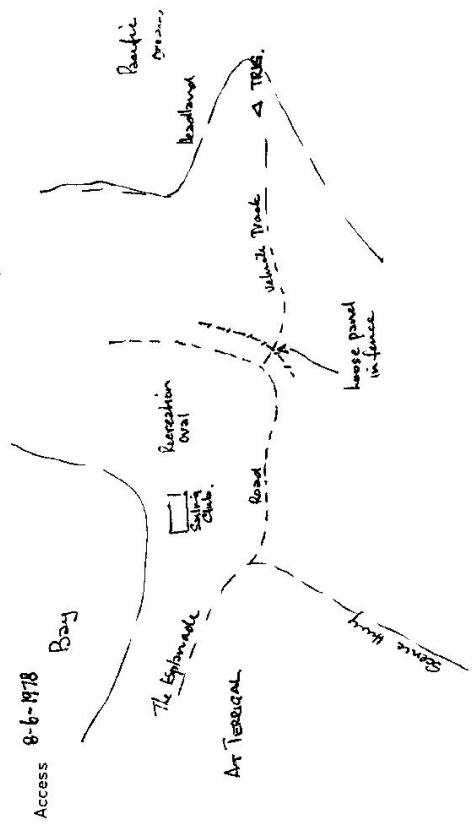

Access 8-6-1978

Not to Scale

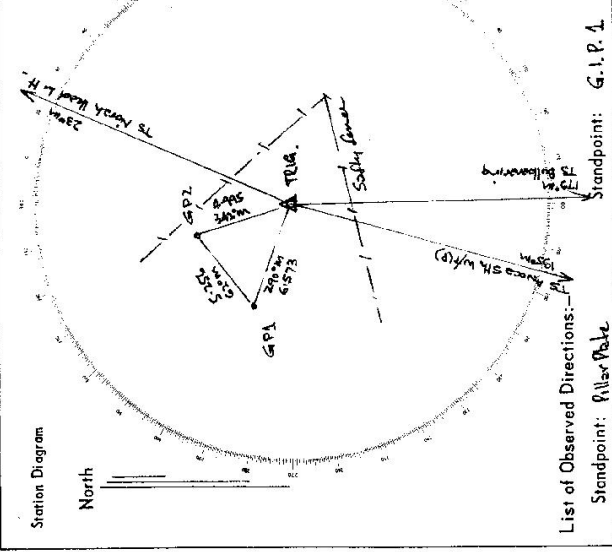

List of Observed Directions: -  
 Standpoint: W. 1st Pk. 1  
 Station: G.I.P. 1

Station	Direction	Station	Direction
TS Bulbarinning	0° 00' 00"	TS Bulbarinning	0° 00' 00"
TS Angus Sh. W/P (P)	14° 51' 54.5"	G.P. 2	283° 26' 44"
G.P. 1	111° 17' 45.5"	TS Skillion (F)	281° 21' 24.5"
G.P. 2	163° 10' 54.5"		
TS North Head L. H	207° 49' 02.5"		