

76-10-9


Department of Lands Integration of N.S.W. RECONNAISSANCE and MAINTENANCE REPORT	STATION WILSON TS 10594 Co: _____ Map Sheet: _____ Inspected by: C. STANLEY No: _____ Date: 27-8-75 Authority: DEPT LANDS Field Book: _____ Beacon Diagram: _____ Not to Scale
This Trig. Station has been:- Note: Cross out word or words which do not apply 1. Completely cleared to permit 360° vision to surrounding Trigs. 2. Cleared by lanes bearing S. 75° to 2.0° M. from Trig. Mast 3. Trig. Mast & Vanes have been painted white & black respectively. 4. The Trig. was unpiled not unpiled , dimensions now being: Description of mark: Beas. Ruck in Coy. Box should be explicit, e.g. Steel plug, Brass plug, Bolt, Concrete Pillar Height of mark: 0.02 m above rock concrete <small>above on G.L.</small> Height of Top Vanes to Top Mark/Top pillar plate: _____ m Diameter of Vanes (vertical): _____ m. Height of Cairn: _____ m. Diameter of Cairn: _____ m. Length of Mast: _____ m. (approximate if not unpiled)	5. A ^{PLUG} steel ^{PLUG} set in conc/ rock has been placed/d 0.02 m. bearing 142 °M from Trig. Mast/pillar 6. A ^{PLUG} concrete ^{PLUG} set in conc/soil has been placed/d 1.54 m. bearing 347 °M from Trig. Mast/pillar 7. A ^{PLUG} steel ^{PLUG} set in conc/soil has been placed/d 1.27 m. bearing 218 °M from Trig. Mast/pillar 8. A steel set in conc/rock has been placed/d _____ m. bearing _____ °M from Trig. Mast/pillar 9. Connection to ^{to} entire 22.137 m. bearing 2 °M 10. Connection _____ to _____ m. bearing _____ °M 11. Connection _____ to _____ m. bearing _____ °M 12. Connection _____ to _____ m. bearing _____ °M 13. Diff. Ht. is 6.2 ^{is 6.2} m. below ^{above} Trig. plug 14. Diff. Ht. is 1.25 ^{is 1.25} m. below ^{above} Trig. plug 15. Diff. Ht. is 2.4 ^{is 2.4} m. below ^{above} Trig. plug 16. Diff. Ht. _____ is _____ m. below ^{above} _____ Prepared by: C. STANLEY Checked: Duffy
Beacon Diagram: _____ Not to Scale	NO BEACON ON WILSON SEE REPORT ON MISERY (Res) IS FOR FURTHER CONNECTION BETWEEN WILSON & MISERY
Date _____ Record of Station _____ _____ _____ _____ _____ _____	

STATION WILSON TS 10594

Owners Name..... Current Occupant.....

Address..... Address.....

Access 27-8-1975
 IN LIONS PARK LOOKOUT
 ON ELIZABETH DRIVE AT GREEN VALLEY.

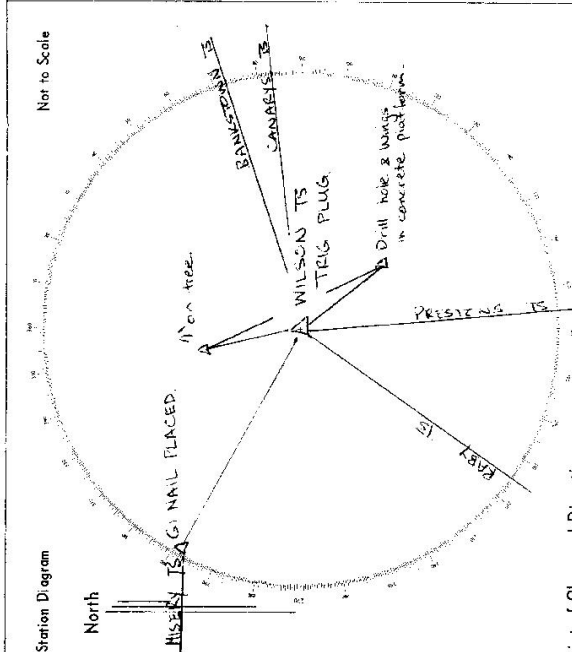

List of Observed Directions:-

Stationpoint: TRIG PLUG		Stationpoint: Drill hole & wings	
Station	Direction	Station	Direction
BANKSTON TS	0° 00' 50"	BANKSTON TS	0° 00' 00"
CANBERRA TS	10° 35' 12.0"	PRESLEY TS	102° 57' 09"
PRESLEY TS	102° 50' 38"	WILSON TS	249° 44' 32"
BANK TS	135° 51' 02.4"	(1) on Tree	266° 04' 14"
G-1 NAIL PLACED	175° 23' 26.2"		

Station	Direction	Station	Direction
BANKSTON TS	0° 00' 00"		
Drill hole & wings (1)	69° 21' 26"		
PRESLEY TS	102° 50' 31"		
(1) on Tree (1)	274° 07' 36"		