

STATION TS BEAUBURN 10597

Current Occupant.....


Address.....

Owners Name.....

Address.....

Station Diagram

North

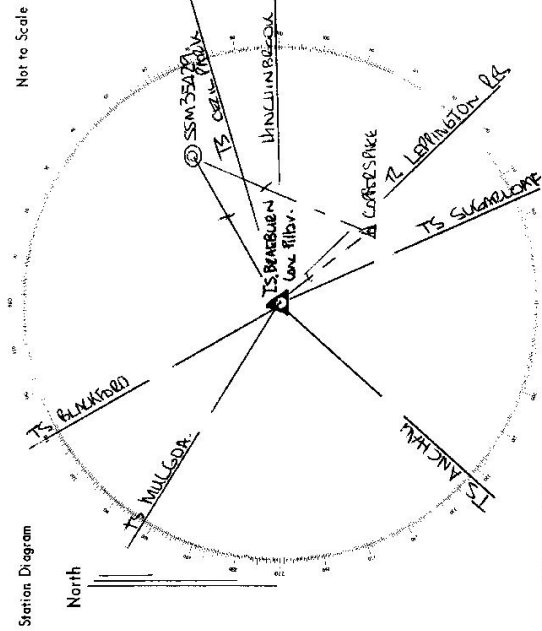

List of Observed Directions:-

Standpoint: Long Millar

Standpoint: Long Millar

| Station | Direction | Station | Direction |
|---------------------|-----------|--------------------------|-----------|
| TS 937 (BLACKWOOD) | 330.00 | TS 24826 (MULGOA) | 72.25 |
| TS 4716 (SUGARLOAF) | 136.24 | TS 24826 (MULGOA) | 248.26 |
| TS 623 (MULGOA) | 222.53 | TS 10360 (LORNINGTON RA) | 136.15 |
| SSM 3537A | 58.41 | TS 37246 (MULGOA) | 302.07 |
| LONGER SPRING | 110.58 | | |
| PM 10650 | 325.37 | | |

At SSM 3537A
 LONGER SPRING
 LONG MILLAR

Direction
 0.00
 35.59

Station
 LONG MILLAR

Direction

