

STATION TS10598 PRESIDENT (P)


Owners Name: Gosford Shire Council

Current Occupant:

Address: Gosford

Address:

- Access 671978
 Km. 0.0
 0-9
 1-9
 2-0
 2-1
- Wentworth
 Inter. Mann St and Donnison St at Gosford
 Travel along Old Pacific Hwy towards Sydney.
 Turn right into Welly St - Sign "President's Hill Lookout"
 Pass concrete water tank on R.H.S.
 Parking area for lookout - follow walking track to East.
 TRIG.

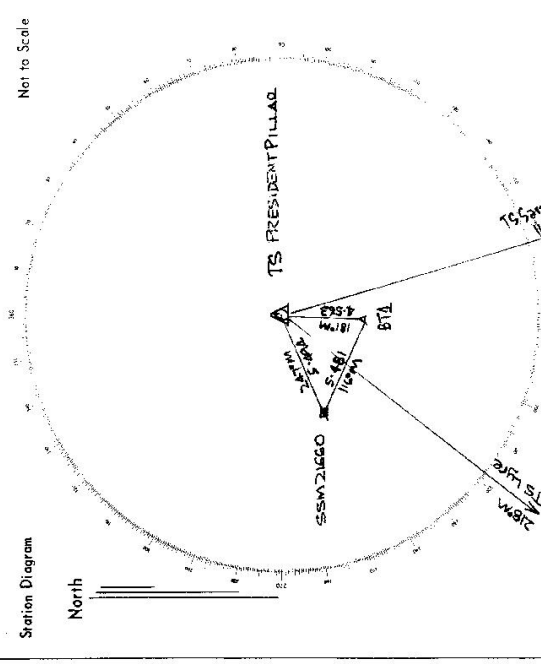

List of Observed Directions:-

Station	Direction	Station	Direction
TS Sarsotoga (P)	0° 00' 00"	TS Sarsotoga (P)	0° 00' 00"
Press Triangle	17° 58' 26"	TS PRESIDENT (P)	263° 18' 44"
SSM 21660	55° 10' 46"	Press Triangle	312° 21' 35"
	83° 16' 46"		

GEODETIC SURVEY OFFICE

CENTRAL MAPPING AUTHORITY

GEODETIC STATION RECONNAISSANCE and MAINTENANCE REPORT

STATION: PRESIDENT (P)	No.: 10598
MAP SHEETS SCALE 1:100 000 SYDNEY SCALE 1:250 000 COSFORD	
INSPECTED BY: O MOSS	DATE: OCT. 1984
AUTHORITY: C. M. A.	FIELD BOOK: —

Description: *Note: Cross out word or words which do not apply*

- Cleared by lanes bearing..... from Trig. Mast
- Mast & Vanes have been painted white & black respectively.
- The station/pillar was unpiled/not unpiled/constructed on..... 19....., dimensions now being:
Description of mark..... should be explicit, e.g., S/Steel Pillar Plate, Steel plug, Brass plug, Bolt, G.I. Pipe
Height of mark..... m. above/below concrete; Mark is..... m. above G.L.
- Height of Top Vanes to Top Mark/Pillar plate..... m. Diameter of Vanes (vertical)..... m.
- Height of Cairn..... m. Diameter of Cairn..... m. Name Plate found/not found/placed.
- Length of Mast..... m. (approximate (not implied))
- A..... set in conc/rock has been placed/found, bearing.....° M from Mast/Plug/Pillar
- A..... set in conc/rock has been placed/found, bearing.....° M from Mast/Plug/Pillar
- A..... set in conc/rock has been placed/found, bearing.....° M from Mast/Plug/Pillar
- A..... set in conc/rock has been placed/found, bearing.....° M from Mast/Plug/Pillar
- Action required:.....

STANDPOINT:		STANDPOINT:		STANDPOINT:		STANDPOINT:	
Mark	Direction	Horiz. Distance	Height Difference	Mark	Direction	Horiz. Distance	Height Difference
			above standpt				above standpt
			below				below
			above standpt				above standpt
			below				below
Prepared by: O MOSS. Checked: Noted on U.T.M. Card. Checked

