


2.9.10.3

Department of Lands **RECONNAISSANCE and MAINTENANCE REPORT** **STATION 15 10599 GLENROWAN (P)**

Integrating survey of N.S.W.

Co: **GLDUNCASTER** Ph: **No: 9233**  
 Map Sheet: **DUNGOO** Date: **7 11 18**  
 Inspected by: **P McBEATH** Field Book: **1163 11**  
 Authority: **ISD**

Beacon Diagram **Not to Scale**

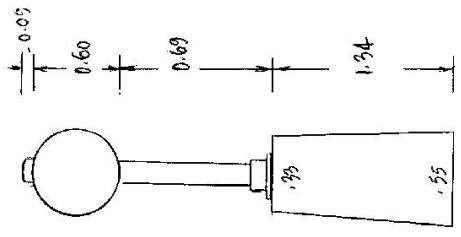

This Trig. Station has been:- **Note: Cross out word or words which do not apply**

1. Completely cleared to permit 360° vision to surrounding Trigs.
2. Cleared by ~~lance-bearing~~ **from Trig. Mast**
3. Trig. Mast & Vanes have been painted white & black respectively.
4. The Trig. was unpiled/~~not unpiled~~, dimensions now being:

Description of mark: **concrete pillar** should be explicit, e.g. Steel plug, Brass plug, Bolt, Concrete Pillar  
 Height of mark: **1.34** m. <sup>above</sup> rock, concrete **1.34** m. <sup>above</sup> G.L.  
 Height of Top Vanes to Top-Mark: Top pillar plate **1.29** m. Diameter of Vanes (vertical) **0.33** m.  
 Height of Cairn **1.34** m. Diameter of Cairn **33 x 55** m.  
 Length of Mast **1.33** m. (approximate if not unpiled)


5. A **SSM 24765** set in conc./~~rock~~ has been placed **at 7.698** m. bearing **355**°M from Trig. Mast/pillar
6. A **C.S.** set in conc./~~soil~~ has been placed **at 9.292** m. bearing **74**°M from Trig. Mast/pillar
7. A **.....** set in conc./soil has been placed **fd** m. bearing **.....**°M from Trig. Mast/pillar
8. A **.....** set in conc./rock has been placed **fd** m. bearing **.....**°M from Trig. Mast/pillar
9. Connection **SSM 24765** to **C.S.** is **10.857** m. bearing **118**°M
10. Connection **.....** to **.....** is **.....** m. bearing **.....**°M
11. Connection **.....** to **.....** is **.....** m. bearing **.....**°M
12. Connection **.....** to **.....** is **.....** m. bearing **.....**°M
13. Diff. Ht. **Pillar Plate** is **1.293** m. <sup>above</sup> **SSM 24765**
14. Diff. Ht. **Pillar Plate** is **1.562** m. <sup>above</sup> **C.S.**
15. Diff. Ht. **SSM 24765** is **0.270** m. <sup>above</sup> **C.S.**
16. Diff. Ht. **.....** is **.....** m. <sup>above</sup> **.....**

Prepared by: **[Signature]** Checked: **CC**

Date	Record of Station

STATION TS 10599 GLENROWAN (P)

Yarrawonga Railway Co  
 Owners Name: Bill Sanson  
 Address: Glenrowan  
 Current Occupant: Dwyer  
 Address: .....

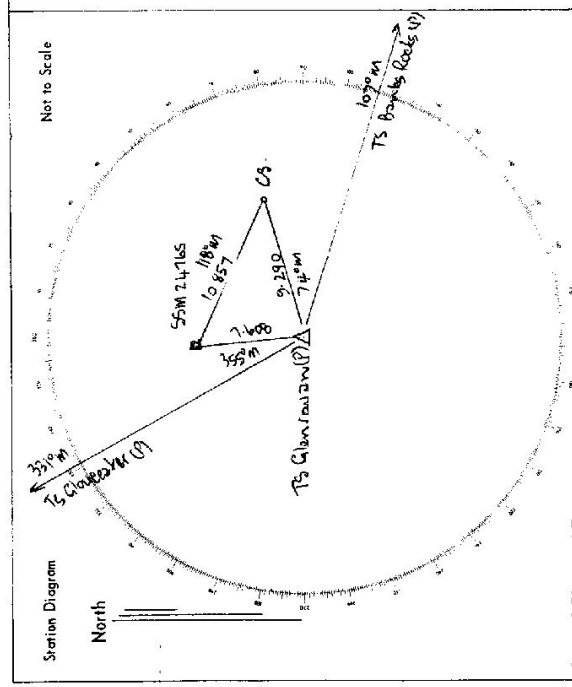

Access 7-11-1978  
 Via Gloucester  
 0.0 Stratford P.O. Travel towards Gloucester  
 0.5 Cross Avon River  
 1.9 Pass under North Coast Railway.  
 4.1 Pass Gloucester Tops road on Left.  
 5.8 Turn right through grid into Property "Glenrowan"  
 6.1 TRIG.

Included drive access in all westons.

List of Observed Directions:-

Standpoint: SSM 24765

Station	Direction	Station	Direction
TS Bombs Rocks (P)	0° 00' 00"	TS Bombs Rocks (P)	0° 00' 00"
TS Glenrowan (P)	227° 00' 22.5"	C.S.	195° 16'
SSM 24765	248° 12' 13.5"	TS Glenrowan (P)	68° 07' 19.5"
C.S.	327° 23' 47"		