

716 10 3

Department of Lands

Integratic ivy of N.S.W.

RECONNAISSANCE and MAINTENANCE REPORT

This Trig. Station has been:-

Note: Cross out word or words which do not apply

1. Completely cleared to permit 360° vision to surrounding Trigs. ✓
2. Cleared by James bearing from Trig. Mast
3. Trig. Mast & Vanes have been painted white & black respectively. ✓
4. The Trig. was unpiled/~~not unpiled~~, dimensions now being:
 - Description of mark: Concrete pillar should be explicit, e.g. Steel plug, Brass plug, Bolt, Concrete Pillar
 - Height of mark: 1.355 m above rock/concrete G.L.
 - Height of Top Vanes to Top pillar plate: 1.45 m Diameter of Vanes (vertical) 0.60 m.
 - Height of Cairn: 1.355 m. Diameter of Cairn 0.33 x .55 m.
 - Length of Mast: 1.54 m. (approximate if not unpiled)
5. A SSM 24766 set in conc/soil has been placed/ ~~is~~ 6.64 m, bearing 9° from Trig. Mast/pillar
6. A C.S. set in conc/soil has been placed/ ~~is~~ 5.98 m, bearing 94° from Trig. Mast/pillar
7. A set in conc/soil has been placed/ ~~is~~ m, bearing °M from Trig. Mast/pillar
8. A set in conc/rock has been placed/ ~~is~~ m, bearing °M from Trig. Mast/pillar
9. Connection SSM to C.S. 8.506 m, bearing 145° 9M
10. Connection to to m, bearing °M
11. Connection to to m, bearing °M
12. Connection to to m, bearing °M
13. Diff. Ht. Pillar Plate is 1.667 m, above below SSM 24766
14. Diff. Ht. Pillar Plate is 1.597 m, above below C.S.
15. Diff. Ht. SSM 24766 is 0.070 m, above below C.S.
16. Diff. Ht. is m, above below

Prepared by: *CCC*

Checked: CCC

STATION TS 10600 LYNROSE (CP)


Co: Gloucester Ph:

Map Sheet: DUNGOG No: 9233

Inspected by: P. M. B. Date: 8.11.78

Authority: ISD WCLE Field Book: PDP 1163

Beacon Diagram

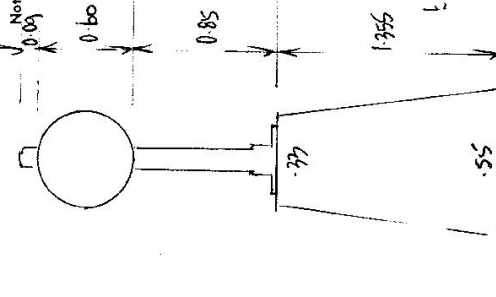


Date	Record of Station
8.11.78	Erected

STATION TS 10600 LYNROSE (P)

Owners Name: Public Roadway. Current Occupant:

Address: Address:

Access 8-11-1978
 Km -
 0.0 Feature
 4.8 Gloucester Hospital - travel south towards Shroud.
 5.9 Turn left onto Fairbairns lane (Gravel)
 6.45 Roulman Crescent
 8.6 Wooden Bridge
 8.7 Take left fork.
 TRIG.
 M western road.

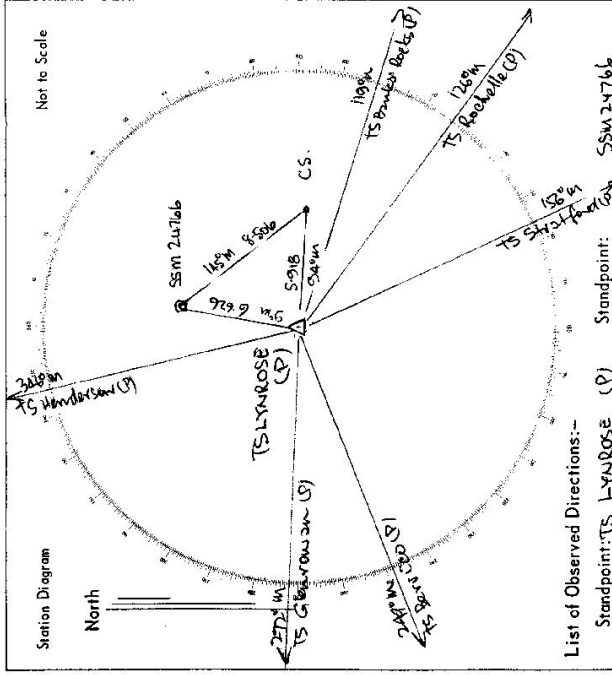

List of Observed Directions:-

Standpoint: TS LYNROSE (P)		Standpoint: SSM 24766	
Station	Direction	Station	Direction
TS Bunker Rocks (P)	0°00' 00"	TS Bunker Rocks	0°00' 00"
TS Rochelle (P)	70°39' 35.21"	C.S.	26°18' 31.5"
TS Shantall (S)	76°32' 28.47"	TS LYNROSE (P)	70°31' 23.5"
TS Barris (S)	130°18' 36.58"		
TS Clonroshan (S)	152°47' 37.17"		
TS Glouceston (S)	199°16' 20.68"		
TS Henderson (S)	223°41' 28.08"		
SSM 24766	258°21' 03"		
CS.	295°20' 18.11"		