


75-16

Department of Lands
 STATION **T3 10601** **ROCHELLE (P)**

Co: **Glauxester** Ph:
 Map Sheet: **Dungog** No: **9233**
 Inspected by: **P. McBeath** Date: **8.11.78**
 Authority: **ISD WCLE** Field Book: **PPR 1163**

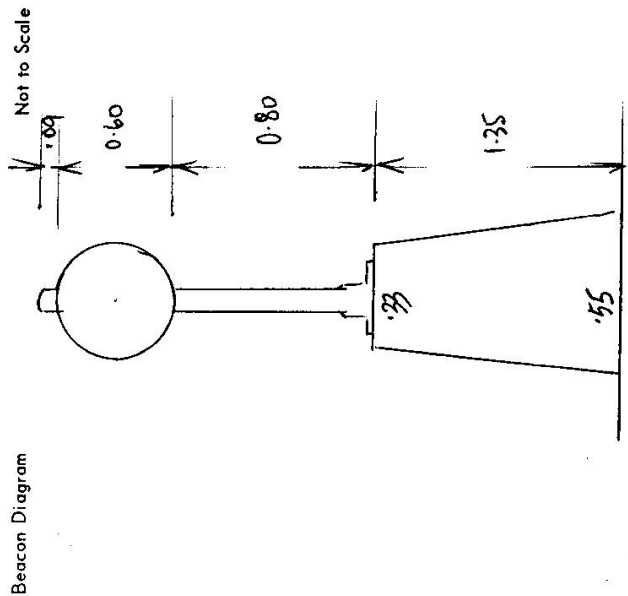

RECONNAISSANCE and MAINTENANCE REPORT

This Trig. Station has been: Note: Cross out word or words which do not apply

1. Completely cleared to permit 360° vision to surrounding Trigs. ✓
2. Cleared by lanes-bearing from Trig. Mast
3. Trig. Mast & Vanes have been painted white & black respectively. ✓
4. The Trig. was unpiled/~~re-constructed~~, dimensions now being:
 Description of mark: Concrete pillar should be explicit, e.g. Steel plug, Brass plug, Bolt, Concrete Pillar
 Height of mark: 1.35 m ^{above} rock/concrete 1.35 m ^{above} G.L.
 Height of Top Vanes to ~~Top Mast~~ Top pillar plate: 1.40 m Diameter of Vanes (vertical) 1.35 m.
 Height of Cairn: 1.35 m. Diameter of Cairn: 33 x 55 m.
 Length of Mast: 1.49 m. (approximate if not unpiled)

5. A SSM 24764 set in conc/~~rock~~ has been placed at 5.973 m. bearing 154° °M from Trig. Mast/pillar
6. A CS set in conc/~~soil~~ has been placed at 5.659 m. bearing 63° °M from Trig. Mast/pillar
7. A CS set in conc/soil has been placed at 5.659 m. bearing 63° °M from Trig. Mast/pillar
8. A CS set in conc/rock has been placed at 8.284 m. bearing 171° °M from Trig. Mast/pillar
9. Connection: SSM 24764 to CS : 8.284 m. bearing 171° °M
10. Connection: SSM 24764 to CS : 8.284 m. bearing 171° °M
11. Connection: SSM 24764 to SSM 24764 : 0.036 m. bearing CS °M
12. Connection: SSM 24764 to SSM 24764 : 0.036 m. bearing CS °M
13. Diff. Hr. Pillar Plate is 1.440 m. ^{above} SSM 24764 SSM 24764
_{below}
14. Diff. Hr. Pillar Plate is 1.477 m. ^{above} SSM 24764 CS
_{below}
15. Diff. Hr. SSM 24764 is 0.036 m. ^{above} SSM 24764 CS
_{below}
16. Diff. Hr. SSM 24764 is 0.036 m. ^{above} SSM 24764 CS
_{below}

Prepared by: [Signature] Checked: [Signature]


Date	Record of Station
<u>Oct 78</u>	<u>Pillar Erected</u>

STATION TS ¹⁰⁶⁰¹ Rochelle (P)

Owners Name: Mrs. Brassington
 Current Occupant: Burns
 Address: Rochelle
 Address: Via Gloucester

Access 8-11-1978
Km. Feature.
 0.0 Gloucester Hospital - travel south towards Shroud.
 4.8 Turn left onto Fairbairns Lane (Gravel)
 5.9 Railway Crossing
 6.45 Wooden Bridge
 8.6 Take left fork.
 10.4 Iron Gate.
 10.45 1st right at end of fence.
 10.5 Turn right through iron gate near house - take tracks
 along ridge - bearing 150°m.
 11.45 Fence opening
 11.7 Fence opening
 12.05 TRIG.

2 wheel drive access in dry.

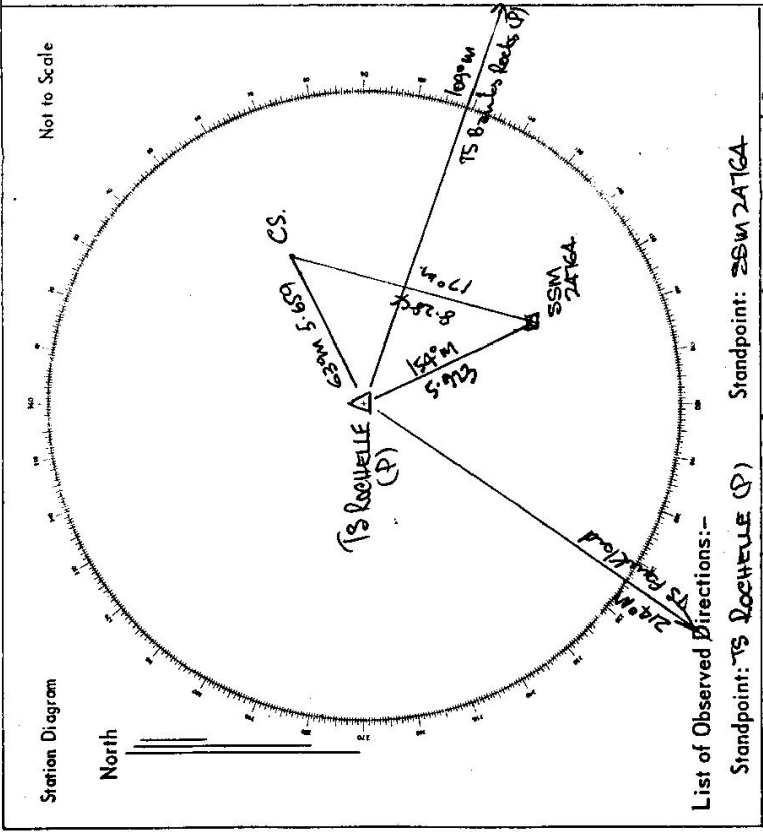

List of Observed Directions:-

Station	Direction	Station	Direction
TS Bombs Rocks (P)	0° 00' 00"	TS Bombs Rocks (P)	0° 00' 00"
SSM 24764	45° 26' 27"	TS Rochelle (P)	225° 38' 10"
TS Foulkland	112° 46' 09"	CS	285° 45' 12"
CS	314° 08' 47"		