


Department of Lands Title: 201 Survey of N.S.W.  
**RECONNAISSANCE and MAINTENANCE REPORT**  
 Station: **TS ROSEVILLE (P) 10602**  
 Co: **GLoucester** Ph: **GLoucester**

Map Sheet: **GLoucester** No: **9233**  
 Inspected by: **A. Graham** Date: **12.10.78**  
 Authority: **ISD Non-removable** Field Book: **P00 114-3**

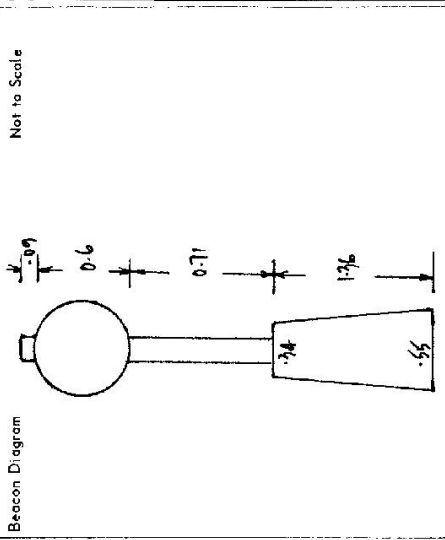

Beacon Diagram Not to Scale

This Trig. Station has been: from Trig-Mast

1. Completely cleared to permit 360° vision to surrounding trigs. ✓
2. Cleared by James bearing from Trig-Mast
3. Trig. Mast & Vanes have been painted white & black respectively. ✓
4. The Trig. was unpiled/~~not unpiled~~, dimensions now being: 1.36 m above G.L.

Description of mark: Concrete Pillar should be explicit, e.g. Steel plug, Brass plug, Bolt, Concrete Pillar  
~~Height of mark~~ 1.36 m above G.L.

- Height of Top Vanes to ~~mark~~ Top pillar plate 1.31 m Diameter of Vanes (vertical) 0.60 m.  
 Height of Cairn 1.36 m. Diameter of Cairn 0.34 x 0.55 m.  
 Length of Mast 1.70 m. (approximate if not unpiled)
5. A 55M 16674 set in conc./rock has been placed 7.516 m bearing 12.4° M from Trig. Mast/pillar
  6. A C.S. set in conc./soil has been placed 6.017 m bearing 22.0° M from Trig. Mast/pillar
  7. A set in conc./soil has been placed fd m bearing ° M from Trig. Mast/pillar
  8. A set in conc./rock has been placed fd m bearing ° M from Trig. Mast/pillar
  9. Connection 55M 16674 to C.S. 9.908 m bearing 244.4° M

10. Connection to to m bearing ° M
11. Connection to to m bearing ° M
12. Connection to to m bearing ° M
13. Diff. Ht. Pillar plate is 1.400 m bearing ° M  
1.395 m <sup>below</sup> 55M 16674
14. Diff. Ht. Pillar plate is 1.404 m bearing ° S  
° S <sup>below</sup>
15. Diff. Ht. 55M 16674 is 0.087 m bearing ° S  
° S <sup>below</sup>
16. Diff. Ht. is is m bearing ° M


Prepared by: P. McBeck Checked: CRD

Date	Record of Station
<u>Oct 1978</u>	<u>Pillar erected.</u>

STATION TS 10 2 ROSEVILLE (P)  
 Owners Name: M. CHASELING  
 Current Occupant: H.E. BLANCH  
 Address: C. LOUCESTER  
 Address: C. LOUCESTER

12-10-1978  
 Access 00 Stratford P.D. Travel north towards Gloucester  
1-5 Turn right at Wellard Cox's Road.  
2-1 Causaway  
4-9 Left through iron gate  
5-2 Through open gateway  
5-5 Gate  
5-6 Trig.

FEATURE  
 Conventional vehicle access in all weather.

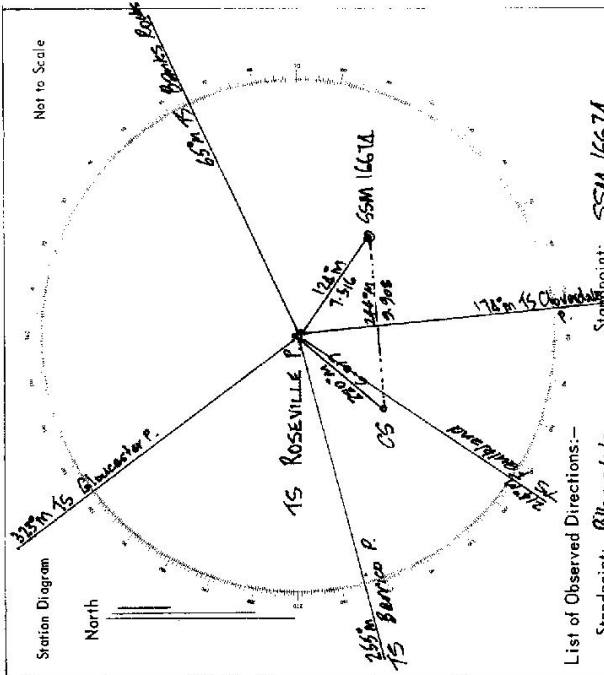

List of Observed Directions:-

Station	Direction	Station	Direction
<u>TS Banks Banks P</u>	<u>D° 00' 00.0"</u>	<u>TS Banks Banks P</u>	<u>D° 00' 00.0"</u>
<u>SSM 1667A</u>	<u>57° 00' 26.6"</u>	<u>CS</u>	<u>199° 30' 38.4"</u>
<u>TS Cloverdale P</u>	<u>108° 21' 24.3"</u>	<u>Pillar plate</u>	<u>237° 08' 36"</u>
<u>TS Faulkland</u>	<u>150° 57' 52.0"</u>		
<u>CS</u>	<u>150° 30' 38.4"</u>		
<u>TS Barrico P</u>	<u>171° 29' 58.0"</u>		
<u>TS Gloucester P</u>	<u>265° 05' 32.0"</u>		