

Department of Lands  
 Trigometrical Survey of N.S.W.  
 RECONNAISSANCE and MAINTENANCE REPORT

This Trig. Station has been:-

Note: Cross out word or words which do not apply

1. Completely cleared to permit 360° vision to surrounding Trigs.
2. Cleared by ~~lines bearing~~ from Trig-Mast
3. Trig. Mast & Vanes have been painted white & black respectively.
4. The Trig. was ~~erected~~ erected, dimensions now being:  
 Description of mark Steel Spigot should be explicit, e.g. Steel plug, Brass plug, Bolt, G.I. Pipe  
 Height of mark 0.00 m <sup>above</sup> ~~below~~ rock/concrete 0.00 m <sup>above</sup> ~~below~~ G.L.  
 Height of Top Vanes to Top Mark 1.48 m. Diameter of Vanes (vertical) 0.60 m.  
 Height of Cairn 0.00 m. Diameter of Cairn 0.00 m.  
 Length of Mast 1.555 m. (approximate if not unplied)

5. A set in conc/rock has been placed 0M bearing 0M from Trig-Mast
6. A set in conc/soil has been placed 0M bearing 0M from Trig-Mast
7. A set in conc/soil has been placed 0M bearing 0M from Trig-Mast
8. A set in conc/rock has been placed 0M bearing 0M from Trig-Mast
9. Connection to 0M bearing 0M
10. Connection to 0M bearing 0M
11. Connection to 0M bearing 0M
12. Connection to 0M bearing 0M
13. Diff. Ht. 0 0M <sup>below</sup> ~~above~~
14. Diff. Ht. 0 0M <sup>below</sup> ~~above~~
15. Diff. Ht. 0 0M <sup>below</sup> ~~above~~
16. Diff. Ht. 0 0M <sup>below</sup> ~~above~~

Prepared by: P. R. Heldon Checked: *P. R. Heldon* Noted on U.T.M. Card

STATION GREEN, ILL RES. (P) TS 10609


Co: Dudley Ph: Yarravel

Map Sheet: KENTPEY 1 25000 No: 9435-1-N

Inspected by: P. R. Heldon Date: 5-7-78

Authority: Lands Dept. Field Book: 1053

Beacon Diagram

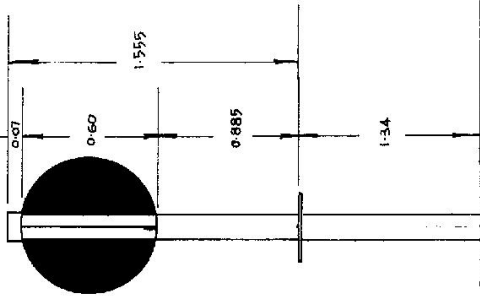

Date 5-7-78 Inspected


Record of Station

Checked

STATION GREENHILL R (P) TS 10609

Owners Name: Kempsey Council  
 Current Occupant: .....  
 Address: .....  
 Address: .....

Access 5-7-1978  
 Situated atop reservoir above 4km from West Kempsey P.O along the  
 Kempsey to Armidale road.

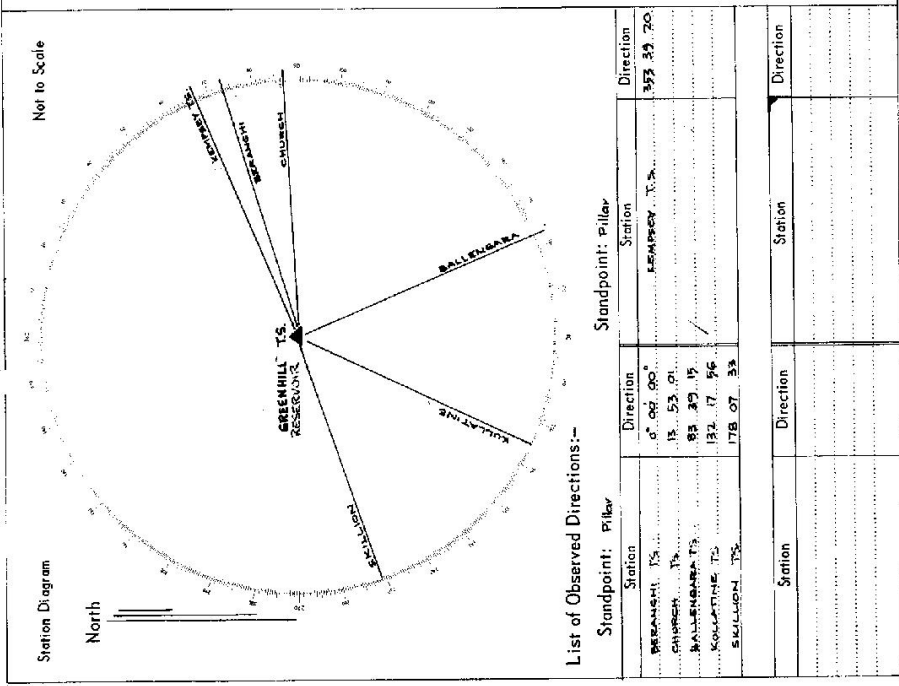

List of Observed Directions:-

Standpoint: Pillar		Standpoint: Pillar	
Station	Direction	Station	Direction
GREENHILL TS	0° 07' 00"	KEMPSEY TS	352° 33' 20"
CHURCH TS	13° 53' 01"		
BALLINGARA TS	83° 33' 15"		
KULLATHINE TS	132° 17' 56"		
SKULLON TS	178° 07' 33"		
Station	Direction	Station	Direction