


STATION TS 10610 APEX (P) TS 10610

Owners Name: Kempsey Council
 Current Occupant:
 Address:
 Address:

Access 10-7-78
 Situated on Pacific Highway 1 Km south of Kempsey P.O.

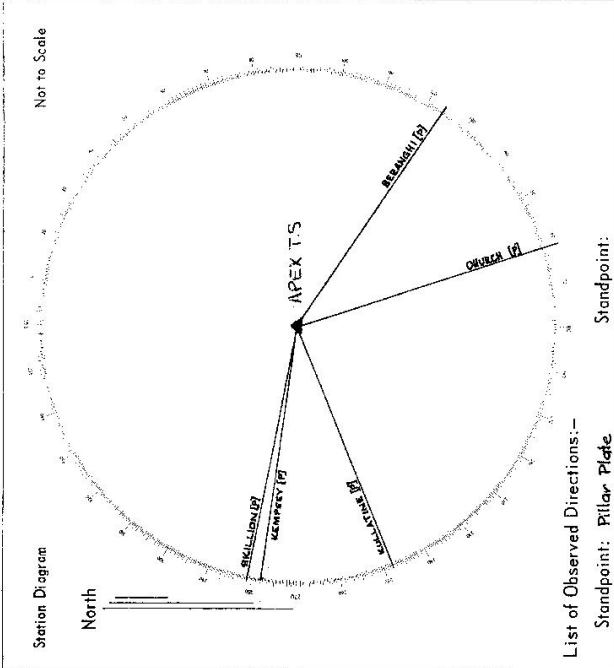

List of Observed Directions:-

Standpoint: Pillar Plate		Standpoint:	
Station	Direction	Station	Direction
Beranghi (P)	0° 00' 00"		
Church (P)	42° 37' 21"		
Kullilone (P)	141° 35' 45"		
Kempsey T.S.	171° 49' 47"		
Kullilone	174° 07' 38"		
Station	Direction	Station	Direction