

74-98

Trigonometrical Survey of N.S.W.

Department of Lands

RECONNAISSANCE and MAINTENANCE REPORT

STATION FREDERICK (PTS. 10612)

This Trig. Station has been:-

Note: Cross out word or words which do not apply

1. Completely cleared to permit 360° vision to surrounding Trigs.

2. Cleared by ~~lanes-bearing~~ from Trig. Mast

3. Trig. Mast & Vanes have been painted white & black respectively.

4. The Trig. was ~~unpiled/not unpiled~~, dimensions now being: Cap of Station Mast 1.1m. not found

Description of mark: Steel Spigot in Pillar should be explicit, e.g. Steel plug, Brass plug, Bolt, G.I. Pipe

Height of mark: 0.00 m ^{above} / 0.00 m _{below} rock/concrete 0.00 m ^{above} / 0.00 m _{below} G.L.

Height of Top Vanes to Top Mark: 1.474 m. / Diameter of Vanes (vertical) 0.596 m.

Height of ~~Cairn~~ ^{Pillar}: 1.265 m. / Diameter of Cairn 0.00 m.

Length of Mast 1.554 m. / (approximate if not unpiled)

5. A ~~set in conc/rock has been placed~~ 0.00 m. bearing 0.00°M from Trig. Mast

6. A ~~set in conc/soil has been placed~~ 0.00 m. bearing 0.00°M from Trig. Mast

7. A ~~set in conc/soil has been placed~~ 0.00 m. bearing 0.00°M from Trig. Mast

8. A ~~set in conc/rock has been placed~~ 0.00 m. bearing 0.00°M from Trig. Mast

9. Connection to 0.00 m. bearing 0.00°M

10. Connection to 0.00 m. bearing 0.00°M

11. Connection to 0.00 m. bearing 0.00°M

12. Connection to 0.00 m. bearing 0.00°M

13. Diff. Ht. is 0.00 m. ^{above} / 0.00 m. _{below}

14. Diff. Ht. is 0.00 m. ^{above} / 0.00 m. _{below}

15. Diff. Ht. is 0.00 m. ^{above} / 0.00 m. _{below}

16. Diff. Ht. is 0.00 m. ^{above} / 0.00 m. _{below}

Prepared by: H. Furner

Checked:

Noted on U.T.M. Card

Co: Dudley Ph: Yarrabandi


Map Sheet: KEMPSEY 1:25000 No: 9435-1-N.

Inspected by: P.R. HELDON Date: 29-6-78

Authority Dept. of LANDS Field Book: 1053/17

Beacon Diagram

Not to Scale

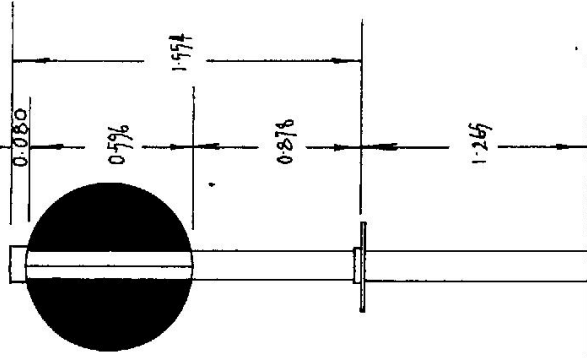

Date 29-6-78 Trig. Obs. carried out

Date	Record of Station
29-6-78	Trig. Obs. carried out

Checked

STATION FREDERICKTON T.S. [P] 10612


Owners Name... Kempsey Shire Council

Current Occupant.....

Address.....

Address.....

Access 29-6-1978
Within the village of Frederickton.

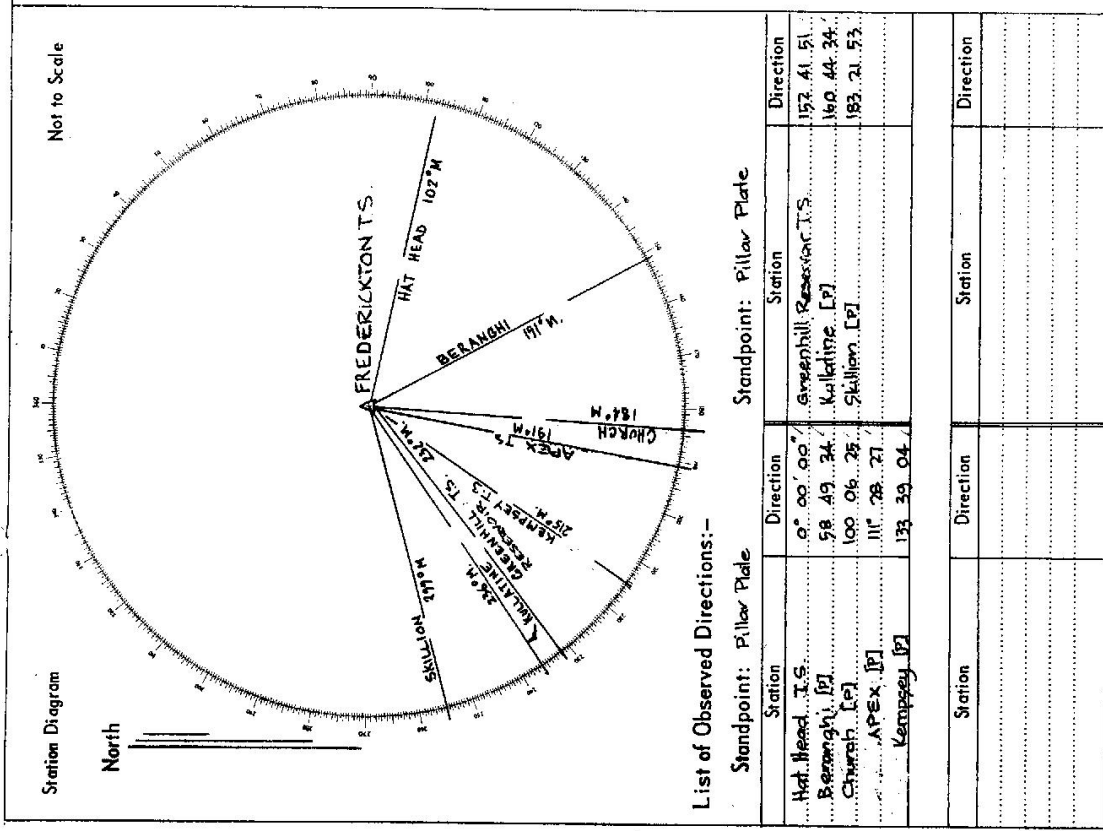

List of Observed Directions:-

Station	Direction	Station	Direction
Hat Head T.S.	0° 00' 00"	Greenhill Reservoir T.S.	152. 41. 51
Beranghi [P]	58. 49. 24	Kalkite [P]	160. 44. 34
Church [P]	100. 06. 25	Skillion [P]	183. 21. 53
APEX [P]	111. 28. 21		
Kempsey [P]	133. 39. 04		