

STATION TS 10615 TEREEL (P)


Owners Name: Forestry Comm......
 Current Occupant: Craven State Forest.....
 Address:
 Address:

Access

Kms

00 Craven P.O Travel South towards Stroud.
 0.35 Turn left into Glen Road towards Craven State Forest.
 6.55 Wooden bridge
 7.10 Grid
 8.40 Take left fork (Brush Forest Rd on right)
 10.75 Straight ahead (Craven Trig turn-off on left)
 10.85 Take right fork (Terrel Forest Rd)
 13.55 Turn left at top of hill (sharply)
 13.65 Trig.

* Accessible by Conventional vehicle in dry weather.

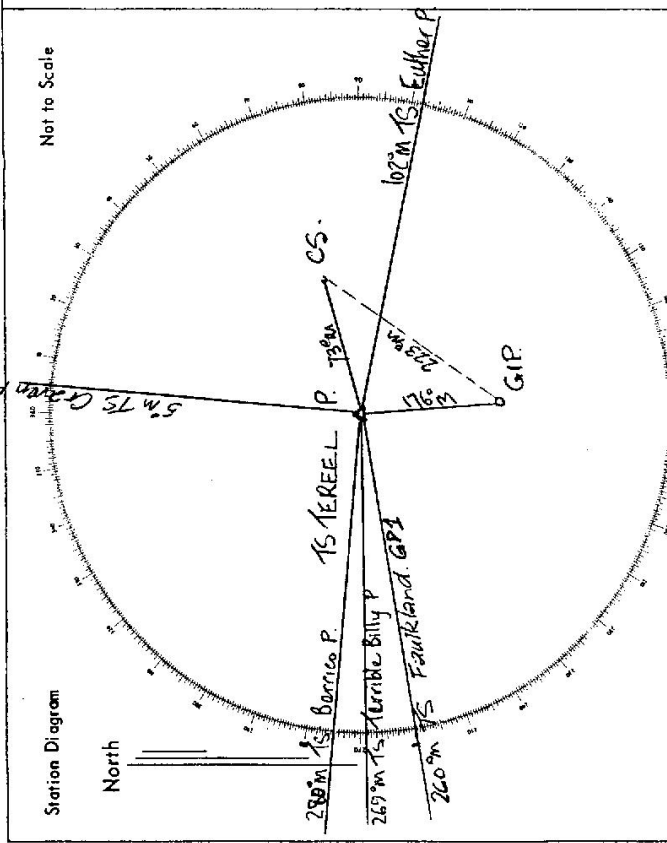

List of Observed Directions:-

Standpoint: Pillar plate. Stationpoint: C.S.

Station	Direction	Station	Direction
TS Euther P	0° 00' 00"	TS Euther P	0° 00' 00"
TS GIP	71° 21' 20.5"	GIP	113° 49' 00"
TS Faulkland GIP	149° 38' 17.92"	Pillar plate	152° 20' 11"
TS Terrel Billy P	158° 01' 56.56"		
TS Berrico P	167° 10' 20.5"		

Station	Direction	Station	Direction
TS Craven P	256° 40' 09.84"		