


75-003

Department of Lands
 STATION TS 10616 TERRIBLE BILLS (P)
 Co: Gloucester
 Ph:
 Map Sheet: Dungoo
 No: 9233
 Inspected by: A. Graham
 Date: 23/11/78
 Authority: SD NELLE
 Field Book: PP 1163
 Beacon Diagram
 Not to Scale

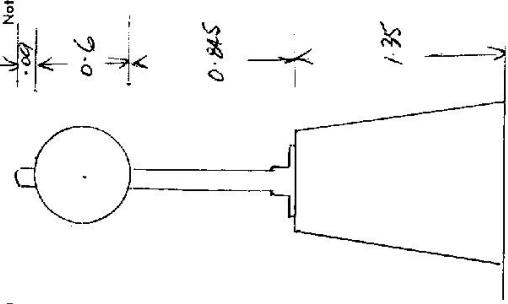

Date	Record of Station
Nov 78	Excavated

RECONNAISSANCE and MAINTENANCE REPORT

Note: Cross out word or words which do not apply

This Trig. Station has been:

1. Completely cleared to permit 360° vision to surrounding Trigs.
2. Cleared by limes bearing from 10° W to 250° W from Trig. Mast
3. Trig. Mast & Vanes have been painted white & black respectively. ✓
4. The Trig. was unpiled/ ~~unpiled~~ dimensions now being:

Description of mark: ~~Concrete pillar~~ should be explicit, e.g. Steel plug, Brass plug, Bolt, Concrete Pillar

Height of mark: ~~rock concrete~~ 1.35 m above G.L.

Height of Top Vanes to ~~Top~~ Top pillar plate: 4.45 m Diameter of Vanes (vertical): 0.60 m.

Height of Cairn: 1.35 m. Diameter of Cairn: 33 x 55 m.

Length of Mast: 1.535 m. (approximate if not unpiled)

5. A SSM 18480 set in conc/rock has been placed to 4.490 m bearing 61° from Trig. Mast/pillar

6. A ~~CS~~ set in conc/soil has been placed to 4.706 m bearing 37° from Trig. Mast/pillar

7. A set in conc/soil has been placed to ... m bearing ...°M from Trig. Mast/pillar

8. A set in conc/rock has been placed to ... m bearing ...°M from Trig. Mast/pillar

9. Connection SSM 18480 to CS 7.237 m bearing 280°

10. Connection to ... m bearing ...°M

11. Connection to ... m bearing ...°M

12. Connection to ... m bearing ...°M

13. Diff. Ht. ~~1.512~~ to ~~SSM 18480~~ is 1.512 m. ~~above~~ ~~below~~

14. Diff. Ht. ~~1.311~~ to ~~CS~~ is 1.311 m. ~~above~~ ~~below~~

15. Diff. Ht. ~~0.201~~ to ~~CS~~ is 0.201 m. ~~above~~ ~~below~~

16. Diff. Ht. is ... m. ~~above~~ ~~below~~

Prepared by: *[Signature]* Checked: *[Signature]*

STATION TS 10616 | TERRIBLE BILLY (P)

Owners Name: Forestry Commission

Current Occupant:

Address:


Address:

Access 23/11/1978
2km. Lezburn
From Craven (Near Gloucester)

0.0 Craven P.O. - travel south towards Street.
3.6 Turn right onto dirt road (Just over Railway Bridge)
Sign marked TUG 27km.

5.10, 5.6, 6.6 Grids
7.0 Take right fork over grid and wooden bridge - Sign Benninging
7.4, 7.85, 8.50, 10.15, 10.90 - Grids
12.5 Grid + Forest sign
20.2 Pass Cherry Tree Rd on left - straight ahead.
24.9 Pass Dungog + Terrible Billy Forest Rd on left - straight ahead
26.9 Turn right off road into clearing just before
sign "Terrible Billy"
26.95 Turn hard right and drive back parallel with
main road.
27.0 TRIG.

2 wheel drive access

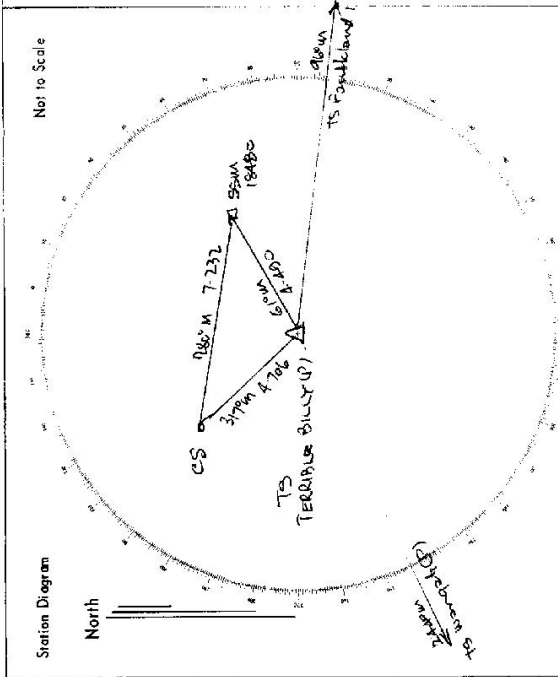

List of Observed Directions:-

Station	Direction	Station	Direction
TS Wangat (P)	10° 06' 00"	SSM 18480	180° 00'
CS	13° 27' 30"	TS Wangat (P)	36° 16' 45"
SSM 18480	177° 05' 145"	TS Terrible Billy (P)	357° 03' 265"
TS Faulkland	224° 41' 00"		