


Department of Lands
 STATION TS 10622 (LIVERPOOL TECH)
 Co: CLIMBERLAND Ph: ST LUKE

Map Sheet: FAIRFIELD 9145 1/10000 No: 9145
 Inspected by: J. KWASNICA Date: 24/1/80
 Authority: DEPARTMENT OF LANDS Field Book:
 Beacon Diagram Not to Scale

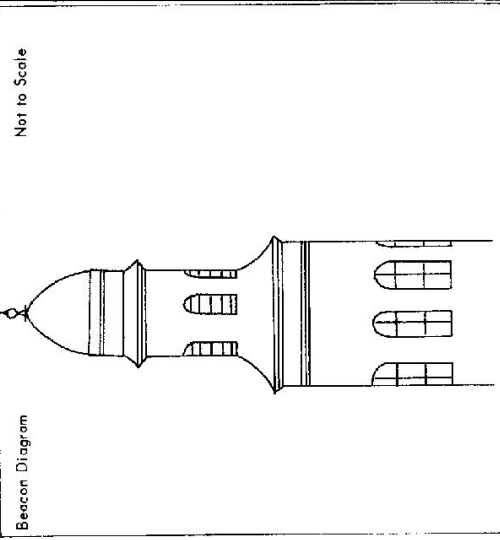

RECONNAISSANCE and MAINTENANCE REPORT
 Integrals Survey of N.S.W.

This Trig. Station has been:-
 Note: Cross out word or words which do not apply

1. Completely cleared to permit 360° vision to surrounding Trigs.
2. Cleared by lances bearing..... from Trig. Mast

3. ~~Trig. Mast & Vanes have been painted white & black respectively.~~ (PASSIVE SPIRE ONLY)

4. The Trig. was unpiled/not unpiled, dimensions now being:

Description of mark..... should be explicit, e.g. Steel plug, Brass plug, Bal, Concrete Pillar
 Height of mark..... m above rock/concrete m below G.L.
 Height of Top Vanes to Top Mark/Top pillar plate..... m Diameter of Vanes (vertical)..... m.
 Height of Cairn..... m. Diameter of Cairn..... m.
 Length of Mast..... m. (approximate if not unpiled)

5. A..... set in conc./rock has been placed/fd..... m. bearing.....°M from Trig. Mast/pillar
6. A..... set in conc./soil has been placed/fd..... m. bearing.....°M from Trig. Mast/pillar
7. A..... set in conc./soil has been placed/fd..... m. bearing.....°M from Trig. Mast/pillar
8. A..... set in conc./rock has been placed/fd..... m. bearing.....°M from Trig. Mast/pillar

9. Connection..... to..... m. bearing.....°M
10. Connection..... to..... m. bearing.....°M
11. Connection..... to..... m. bearing.....°M
12. Connection..... to..... m. bearing.....°M

13. Diff. Ht. is..... m. above below
14. Diff. Ht. is..... m. above below
15. Diff. Ht. is..... m. above below
16. Diff. Ht. is..... m. above below


Prepared by: JULIAN KWA SNICA Checked:

Date	Record of Station

STATION TS 10622 (LIVERPOOL TECH)

Current Occupant... DEPT OF TERTIARY STUD.
 Owners Name... STATE GOVERNMENT
 Address... GOVERNMENT HOUSE
 Address... COLLEGE ST
 Address... MACQUARIE ST, SYDNEY
 Address... LIVERPOOL, NSW.


Access 24-1-1980

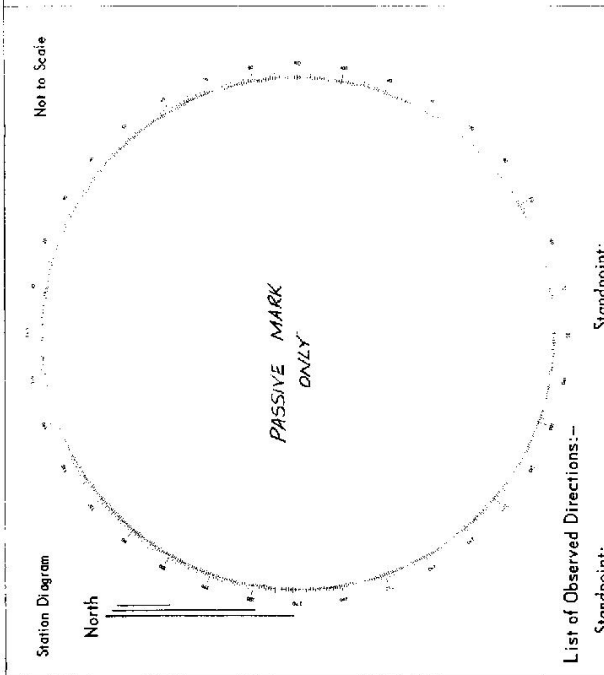

List of Observed Directions:-

Standpoint:		Standpoint:	
Station	Direction	Station	Direction

Station	Direction	Station	Direction

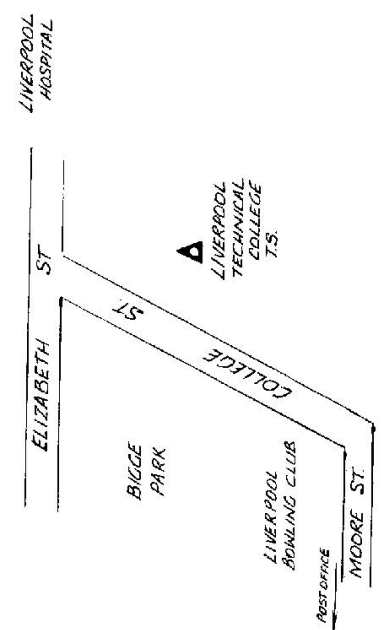

D. West, Government Printer, New South Wales - 1976