

25.18

Department of Lands
 RECONNAISSANCE and MAINTENANCE REPORT

Integrated survey of N.S.W.

This Trig. Station has been:-

Note: Cross out word or words which do not apply

1. Completely cleared to permit 360° vision to surrounding ~~trigon~~
2. Cleared by lanes bearing 20°M to 260°M from Trig. Mast
3. Trig. Mast & Vanes have been painted white & black respectively. ✓
4. The Trig. was unpiled/~~not unpiled~~, dimensions now being:
 - Description of mark: **ROOFTOP BEACON** should be explicit, e.g. Steel plug, Brass plug, Bolt, Concrete Pillar
 - Height of mark: 1.305 m above ~~rock~~ concrete **1.305** m above G.L.
 - Height of Top Vanes to ~~top of pillar~~ Top pillar plate 1.445 m Diameter of Vanes (vertical) 0.60 m.
 - Height of Cairn: 1.235 m. Diameter of Cairn m.
 - Length of Mast: 1.525 m. (approximate if not unpiled)
5. A ~~Copper Spike~~ set in conc/~~rock~~ has been placed at 3.516 m bearing 340°M from Trig. ~~Mast~~ pillar
6. A ~~SSM~~ **SSM** set in ~~concretion~~ **rock** has been placed at 5.761 m bearing 233°M from Trig. ~~Mast~~ pillar
7. A ~~Bolt~~ set in conc/~~rock~~ has been placed at 34.643 m bearing 180°M from Trig. ~~Mast~~ pillar
8. A set in conc/rock has been placed at m bearing°M from Trig. Mast/pillar
9. Connection ~~SSM~~ to ~~Spike~~ **7.77** m bearing 26°M
10. Connection ~~SSM~~ to ~~Bolt~~ **31.062** m bearing 160°M
11. Connection to m bearing°M
12. Connection to m bearing°M
13. Diff. Ht. ~~SSM~~ is 1.464 m ~~above~~ **Pillar Plate**
14. Diff. Ht. ~~Bolt~~ is 3.326 m ~~below~~ **Pillar Plate**
15. Diff. Ht. ~~Copper Spike~~ is 1.523 m ~~below~~ **Pillar Plate**
16. Diff. Ht. is m ~~above~~ **below**

Prepared by: **L.M. HAYES** Checked: _____

STATION TS 10623 MYOORA (P)

Co: NORTHUMBERLAND Pt: NARARA


Map Sheet: GOSFORD 1:25,000 No: 9131-11-S

Inspected by: L.M. HAYES Date: MARCH 1979

Authority DEPT LANDS Field Book: 1291

Beacon Diagram

Not to Scale

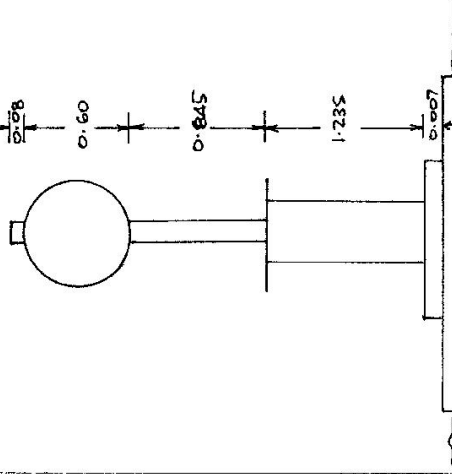

Date: 25-3-79

Record of Station: **Pillar erected.**

CENTRAL MAPPING / THORITY

GEODETTIC SURVEY OF N.S.W.

GEODETTIC STATION RECONNAISSANCE and MAINTENANCE REPORT

Description:

1. Cleared by Vane bearing.....
Note: Cross out word or words which do not apply
2. Mast & Vane have been painted white & black respectively.
..... from Trig. Mast
3. The station/pillar was unpiled/constructed on..... 19....., dimensions now being:
Description of mark.....
Height of mark..... m. ^{above} _{below} rock/concrete. Mark is..... m. ^{above} _{below} G.L.

4. A..... m. Diameter of Cairn..... m. Name Plate found/not found/placed.
Length of Mast..... m. (approximate if not unpiled)
5. A..... set in conc/rock has been placed/found, bearing..... ° M from Mast/Plug/Pillar
6. A..... set in conc/rock has been placed/found, bearing..... ° M from Mast/Plug/Pillar
7. A..... set in conc/rock has been placed/found, bearing..... ° M from Mast/Plug/Pillar

B. Action required:.....

STANDPOINT:

STANDPOINT:

Mark	Direction	Horiz. Distance	Height Difference	Mark	Direction	Horiz. Distance	Height Difference
			above standpt				above standpt
			below				below
			above standpt				above standpt
			below				below
Prepared by: O. Moss

Checked: Noted on U.T.M. Card

STATION: MYOORA T.S. No.: 10623
 MAP SHEETS SCALE 1:100 000 SYDNEY GOSFORD
 INSPECTED BY: O. MOSS DATE: OCT. 1984
 AUTHORITY: C. M. A. FIELD BOOK:

