

75/02

Department of Lands

Integral Survey of N.S.W.  
RECONNAISSANCE and MAINTENANCE REPORT

STATIONS 10631 BOWERS CREEK (P)

This Trig. Station has been:-

Note: Cross out word or words which do not apply

1. Completely cleared to permit 360° vision to surrounding Trigs. ✓
2. Cleared by ~~James bearing~~ ---from Trig. Mast---
3. Trig. Mast & Vanes have been painted white & black respectively. ✓
4. ~~The Trig. was unplied/not unplied, dimensions not being---~~

Description of mark: CONCRETE PILLAR should be explicit, e.g. Steel plug, Brass plug, Bolt, Concrete Pillar

Height of mark: 1.380 m above rock/concrete 1.380 m above G.L.

Height of Top Vanes to Top Mast/Top pillar plate: 1.41 m Diameter of Vanes (vertical): 0.60 m.


- ~~Height of Cairn~~ m Diameter of Cairn m
- Length of Mast: 1.51 m ~~(approximate if not unplied)~~
5. ASSM. 3671.9 set in conc/teak has been placed 46.361 m, bearing 295° from Trig. Mast/pillar
  6. A. <sup>capex spike</sup> set in conc/soil has been placed 45.818 m, bearing 294° from Trig. Mast/pillar
  7. A. set in conc/soil has been placed fd m, bearing ° from Trig. Mast/pillar
  8. A. set in conc/rock has been placed fd m, bearing ° from Trig. Mast/pillar

9. Connection: ..... to ..... m, bearing .....°M
10. Connection: ..... to ..... m, bearing .....°M
11. Connection: ..... to ..... m, bearing .....°M
12. Connection: ..... to ..... m, bearing .....°M
13. Diff. Ht. .... is ..... m, above/below
14. Diff. Ht. .... is ..... m, above/below
15. Diff. Ht. .... is ..... m, above/below
16. Diff. Ht. .... is ..... m, above/below

Prepared by: W. S. ... Checked: M. ... 14/8/80

Co: ARGVILLE Ph: TOBRANG  
Map Sheet: TOVRANG No: 8828-1-5  
Inspected by: P. HARRISON Date: 15-3-80  
Authority: INTEGRATION SURVEYS Field Book: 756/17

Beacon Diagram Not to Scale

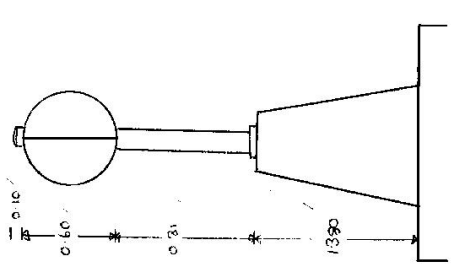

Date	Record of Station
14/8/80	KULAB STATION ESTABLISHED.

