

7-5-19

Department of Lands
Integr Survey of N.S.W.
RECONNAISSANCE and MAINTENANCE REPORT

STATION TS 10638 WAKEHURST [P]
Co: Cumberland Pl: Manly Cove
Map Sheet: Frenchs Forest No: 1860
Inspected by: H.G. HELSHAM Date: 10-5-79
Authority: DEPT OF LANDS Field Book: 1306
Beacon Diagram Not to Scale

This Trig. Station has been: *Note: Cross out word or words which do not apply*

- 1. Completely cleared to permit 360° vision to surrounding Trigs
- 2. Cleared by tenes-bearing
- 3. Trig. Mast & Vanes have been painted white & black respectively. **NO BEACON ERRECTED**
- 4. The Trig. was omitted / not omitted / dimensions now being **NEW STATION**

Description of mark: **CONCRETE PILLAR** should be explicit, e.g. Steel plug, Brass plug, Bolt, Concrete Pillar
 Height of mark: 1.400 m above ~~mean~~ concrete 0.15 m above G.L.
 Height of Top Vanes to Top Mark / Top pillar plate: m Diameter of Vanes (vertical) m.

Height of Cairn: m Diameter of Cairn: m

Length of Mast: m (approximate, if not specified)

- 5. A ~~SSM~~ **BT1** set in ~~conc/rock~~ **rock** has been placed ~~9.187~~ 14.7 m bearing ~~14.7~~ from Trig. ~~Mast~~ / pillar
- 6. A ~~Brass~~ **BT2** set in ~~concrete~~ **rock** has been placed ~~12.948~~ 54 m bearing ~~54~~ from Trig. ~~Mast~~ / pillar
- 7. A ~~Brass~~ **BT2** set in ~~concrete~~ **rock** has been placed ~~35.228~~ 14.5 m bearing ~~14.5~~ from Trig. ~~Mast~~ / pillar
- 8. A set in ~~conc/rock~~ has been placed / id m bearing m from Trig. Mast / pillar

9. Connection ~~SSM~~ to BT.1: 15:651 m, bearing 16 m

10. Connection ~~SSM~~ to BT.2: 28:742 m, bearing 144 m

11. Connection: to: m, bearing m

12. Connection: to: m, bearing m

13. Diff. Ht. ~~SSM~~ **BT2** is: 1:529 m ~~above~~ **Pillar Plate**

14. Diff. Ht. ~~BT1~~ is: 1:706 m ~~below~~ **Pillar Plate**


15. Diff. Ht. ~~BT2~~ is: 1:798 m ~~above~~ **Pillar Plate**

16. Diff. Ht. is: m ~~above~~ **Pillar Plate**

Prepared by: *Handwritten signature*

Checked:


NO BEACON ERRECTED

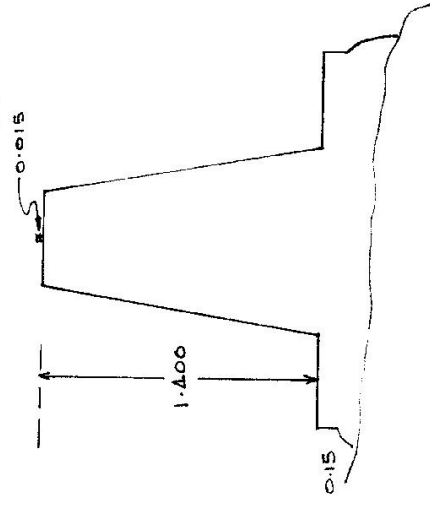

Date	Record of Station
10-5-79	Pillar & Station Marks Placed


STATION TS 10638 WAKEHURST [P]

Owners Name.....
 Current Occupant.....
 Address.....
 Address.....
 Access 10-5-1979
 As per diagram
 Pillar is visible from
 Road.

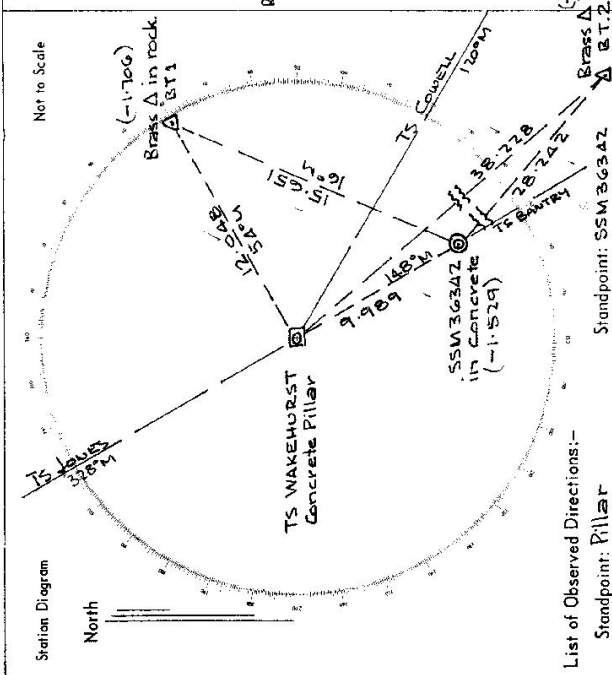

List of Observed Directions:-

Station	Direction	Station	Direction
TS CONELL	0° 00' 00"	TS BANTRY	0° 00' 00"
BT2	28 11 58	TS JONES	180 00 02
SSM 36342	29 27 28	WAKEHURST PILLAR	180 00 24
TS JONES	209 26 47	BT1	230 20 59
BT1	299 27 08	BT2	358 19 15
TS BANTRY	27 26 43		
Standpoint: BT2		Standpoint: BT1	
TS BANTRY	0° 00' 00"	TS JONES	0° 00' 00"
SSM 36342	178 15 22	SSM 36342	231 57 16
WAKEHURST PILLAR	178 41 52	WAKEHURST PILLAR	271 56 37
TS JONES	179 50 13		

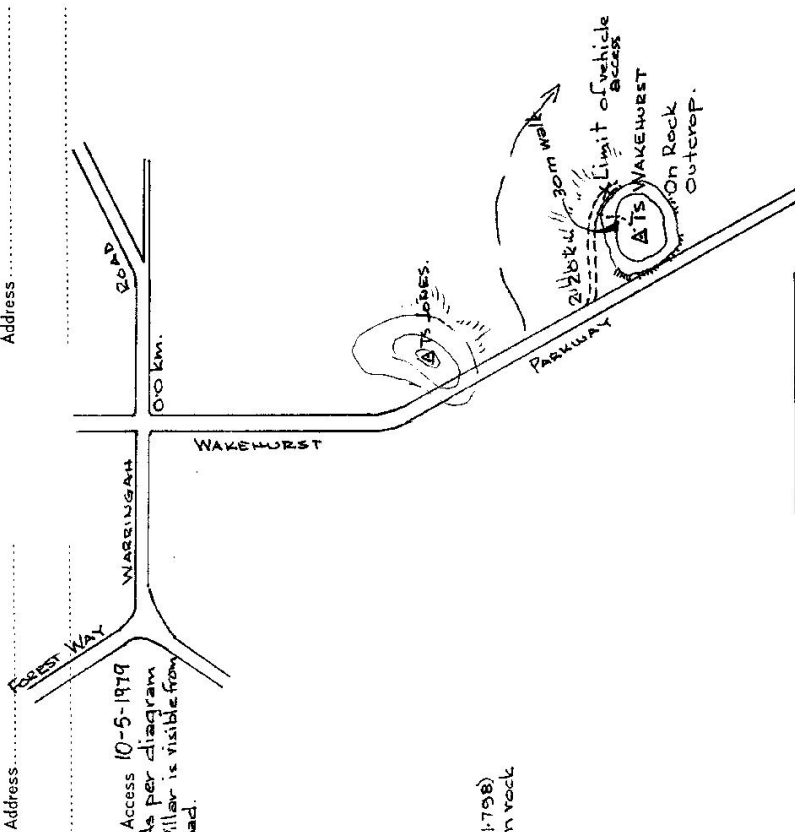

D. West, Government Printer, New South Wales - 1976