

STATION TS 10642 HARNES CASK

Owners Name Crown Land


Current Occupant

Address

Address

Station Diagram Not to Scale

North

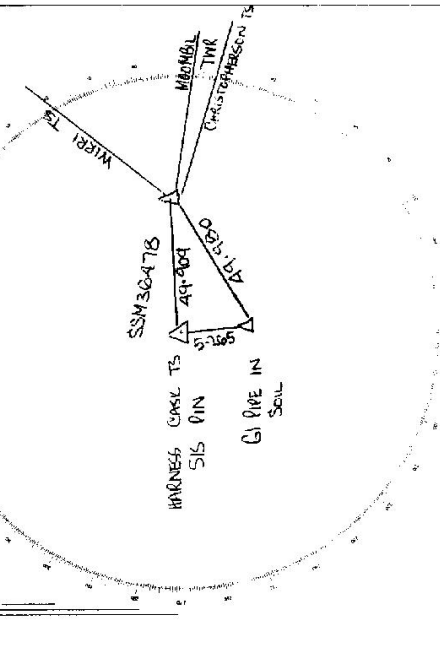

List of Observed Directions:-

Station	Direction	Station	Direction
MOONBIL TMR	87 00 00	SSM3647B	0 00 00
CHRISTOPHERSON TS	93 41 05	GI PIPE	87 45 52
MICKI TS	23 45 40		
GI PIPE	247 59 44		
HARNES CASK TS	254 02 28		

Access 12.6 1978
 AT TYRINGHAM ON GRAFTON - ARMIDALE ROAD
 TRAVEL TOWARDS ARMIDALE & HERNANI
 About 6kms from TYRINGHAM TAKE TYLERS RD
 ON LEFT.

These 125000 maps required for access to
 DUNDURRABIN
 HERNANI
 DERRIGO

- 0.0 TAKE TYLERS RD
- 3.7 HOUSE ON RIGHT
- 4.0 GATE
- 4.4 WOODEN GATE
- 4.7 GATE
- 5.1 WATER CROSSING
- 5.5 BRIDGE
- 5.6 GATE
- 7.5 GATE
- 8.4 TAKE TRACK TO LEFT ALONG FENCE
- 8.8 BRIDGE THEN GATE
- 9.1 TAKE TRACK TO LEFT
- 9.6 WIRE GATE DAM ON LEFT
- 10.1 CREEK CROSSING
- 10.7 TAKE 100M GATE ON RIGHT TRACK CURVES TO RIGHT TO TOP OF RIDGE
- 12.1 GATE
- 12.2 DAM ON LEFT
- 12.4 TS