


Department of Lands  
 RECONNAISSANCE and MAINTENANCE REPORT  
 Integration: City of N.S.W.

STATIONARY LIGHTS DARLING HARBOUR [P]  
 Co: CUMBERLAND CITY OF SYDNEY  
 Map Sheet: SYDNEY 1 120000 No: 1845  
 Inspected by: S. Greening Date: 3. 8. 79  
 Authority: D.M.R. Field Book: C.S. 145  
 Beacon Diagram Not to Scale

This Trig. Station has been: Integrated

- Note: Cross out word or words which do not apply
1. Completely cleared to permit 360° vision to surrounding Trigs. ✓
  2. ~~Cleared by James bearing~~ from Trig. Mast
  3. Trig. Mast & Vanes have been painted white & black respectively.
  4. The Trig. ~~was supplied with~~ steel roof, dimensions now being: 1.28 m above concrete roof 1.28 m below G.L.  
 Description of mark: steel roof pillar should be explicit, e.g. Steel plug, Brass plug, Bolt, Concrete Pillar  
 Height of mark: 1.28 m above concrete roof 1.28 m below G.L.  
 Height of Top Vanes to Top Mast/Top pillar plate: 0.98 m Diameter of Vanes (vertical): 0.44 m.  
 Height of ~~Centre~~ Centre: 1.28 m. Diameter of ~~Centre~~ Centre: 0.44 m.
- Length of Mast: 1.07 m (approximate if not unplied)  
1.15 to top of cone
5. A Nail set in conc./~~soil~~ has been placed at 2.015 m. bearing 205°M from Trig. ~~Mast~~ pillar
  6. A Nail set in conc./~~soil~~ has been placed at 4.999 m. bearing 95°M from Trig. ~~Mast~~ pillar
  7. A Nail set in conc./~~soil~~ has been placed at 4.205 m. bearing 48°M from Trig. ~~Mast~~ pillar
  8. A Nail set in conc./rock has been placed at 0.00 m. bearing 0°M from Trig. Mast/pillar

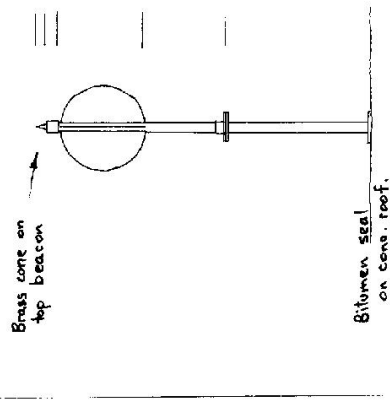

Date	Record of Station
1976	Installed
1979	Co-ordinated (156)

Hi. Pillar Plate 303.30m AHD

Prepared by: K. Bridges Checked: S. Greening

**STATIONS 10669 DARLING HARBOUR [P]**

Owners Name..... P. M. R.  
 Current Occupant..... P. M. R.  
 Address..... CASTLEBEACH ST.  
 Address..... 142 Day St.  
 SYDNEY  
 Darling Harbour

Access 3-8-1979  
 SEE SUPERVISING SURVEYOR IN BUILDING BEFORE PROCEEDING TO TRIG.  
 TRIG ON N.E. CORNER OF BUILDING N°142 DAY ST. (CORNER DAY &  
 DRUITT STS). TAKE STAIRS AT S.W. CORNER OF BUILDING TO ROOF.  
 TRIG CAN BE SEEN ON TOP OF LIFT MOTOR ROOM.

