


STATION TS TURRAMURRA

Owners Name... QUEEN'S PARK
 Address... PACIFIC HIGHWAY
 TURRAMURRA

Current Occupant.....
 Address.....

Access 24-7-1979

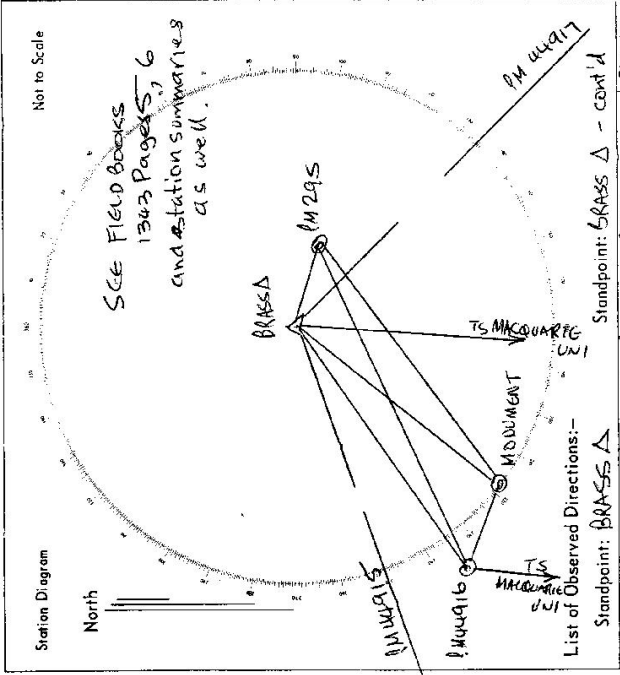

List of Observed Directions:-
 Standpoint: BRASS Δ

Station	Direction	Station	Direction
TS MACQUARIE UNI	190° 00' 00"	PM 41917	13481' 00"
TS TURRAMURRA	234° 15' 17"		
PM 41916	238° 16' 50"		
PM 41915	248° 16' 23"		
PM 295	117° 56' 22"		
Standpoint: PM 41916			
TS MACQUARIE UNI	190° 00' 00"		
PM 295 BT	60° 48' 13"		
PM 295	62° 32' 23"		
TS TURRAMURRA	94° 54' 15"		