

75/99

Department of Lands Integral Survey of N.S.W.

RECONNAISSANCE and MAINTENANCE REPORT

STATION TS 10676 COURALLIE

Co: <u>COURALLIE</u>	Ph: <u>MORÉE</u>	No: <u>SS50-11611</u>
Map Sheet: <u>MORÉE 1:50000</u>	Date: <u>16-10-78</u>	
Inspected by: <u>G. SPIKE</u>	Field Book: <u>POP 1151</u>	
Authority: <u>MORÉE LAB</u>	Beacon Diagram Not to Scale	

This Trig. Station has been:- Note: Cross out word or words which do not apply

1. Completely cleared to permit 360° vision to surrounding Trigs.
2. Cleared by lanes bearing from Trig. Mast
3. Trig. Mast & Vanes have been painted white & black respectively.
4. The Trig. was unpiled/not unpiled, dimensions now being: NEW MARK
 Description of mark: DRILL HOLE & WINGS should be explicit, e.g. Steel plug, Brass plug, Balr, Concrete Pillar

Height of mark m ^{above}/_{below} rock/concrete m ^{above}/_{below} G.L.

Height of Top Vanes to Top Mark/Top pillar plate m Diameter of Vanes (vertical) m.

Height of Cairn m. Diameter of Cairn m.

- Length of Mast m. (approximate if not unpiled)
5. A..... set in conc/rock has been placed/fd m. bearing°M from Trig. Mast/pillar
 6. A..... set in conc/soil has been placed/fd m. bearing°M from Trig. Mast/pillar
 7. A..... set in conc/soil has been placed/fd m. bearing°M from Trig. Mast/pillar
 8. A..... set in conc/rock has been placed/fd m. bearing°M from Trig. Mast/pillar

9. Connection..... to..... m. bearing.....°M
10. Connection..... to..... m. bearing.....°M
11. Connection..... to..... m. bearing.....°M
12. Connection..... to..... m. bearing.....°M
13. Diff. Ht. is..... m. ^{above}/_{below}
14. Diff. Ht. is..... m. ^{above}/_{below}
15. Diff. Ht. is..... m. ^{above}/_{below}
16. Diff. Ht. is..... m. ^{above}/_{below}

Prepared by: William Howard Macdonald Checked: GD

Trig. Ht. 239.2 m.

Date	Record of Station

DRILL HOLE & WINGS

25-10-8

Department of Lands

Integrat survey of N.S.W.

RECONNAISSANCE and MAINTENANCE REPORT

STATION T.S. 10676 COURALLIE

This Trig. Station has been:-

Note: Cross out word or words which do not apply

1. Completely cleared to permit 360° vision to surrounding Trigs.
2. Cleared by lanes bearing..... from Trig. Mast
3. Trig. Mast & Vanes have been painted white & black respectively.
4. The Trig. was unpiled/not unpiled, dimensions now being:


Description of mark.....
 Height of mark..... m above rock/concrete
 Height of Top Vanes to Top-Mark/Top pillar plate..... m Diameter of Vanes (vertical)..... m.
 Height of Cairn..... m. Diameter of Cairn..... m.
 Length of Mast..... m. (approximate if not unpiled)

5. A..... set in conc/rock has been placed/fd..... m. bearing.....°M from Trig. Mast/pillar
6. A..... set in conc/soil has been placed/fd..... m. bearing.....°M from Trig. Mast/pillar
7. A..... set in conc/soil has been placed/fd..... m. bearing.....°M from Trig. Mast/pillar
8. A..... set in conc/rock has been placed/fd..... m. bearing.....°M from Trig. Mast/pillar

9. Connection..... to..... m. bearing.....°M
10. Connection..... to..... m. bearing.....°M
11. Connection..... to..... m. bearing.....°M
12. Connection..... to..... m. bearing.....°M
13. Diff. Ht. is..... m. above below
14. Diff. Ht. is..... m. above below
15. Diff. Ht. is..... m. above below
16. Diff. Ht. is..... m. above below

Prepared by: R.J. DUNNING Checked: B. POWIS

Co: COURALLIE Ph: MOREE
 Map Sheet: 1/4,000 DISTRICT MAP SERIES No: NBIHO-7
 Inspected by: R.J. DUNNING Date: 22-1-85
 Authority: MOREE LANDS OFFICE Field Book:

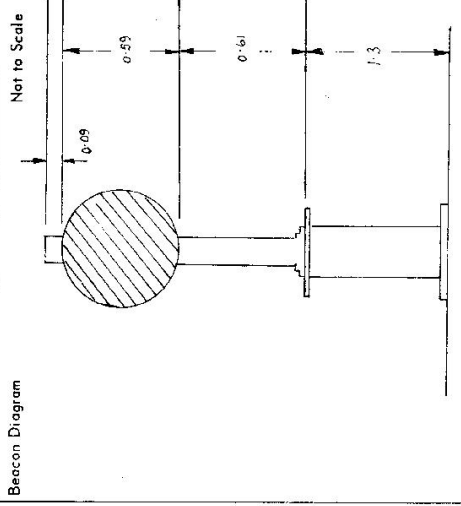

Date	Record of Station
22/1/85	A PILLAR WAS ERECTED OVER A DRILL HOLE IN THE STEEL DECK OF RESERVOIR

TS. 10676

STATION: COURALLIE (P)

No.: TS10676

MAP SHEET
SCALE 1:250 000

Moree

DRAWN BY
INSPECTED BY


D. Kain

DATE: 2.8.1995

AUTHORITY:

LIC

FIELD BOOK:

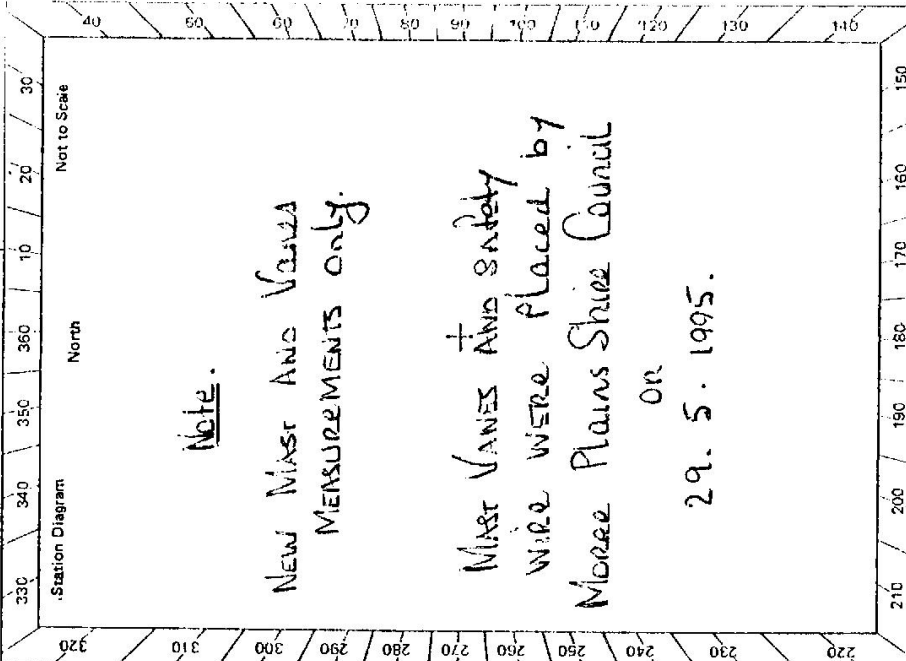

LAND INFORMATION CENTRE

GEODETIC SURVEY OF N.S.W.

GEODETIC STATION RECONNAISSANCE and MAINTENANCE REPORT

Description: *Note: Cross out word or words which do not apply*

1. Cleared by Janes bearing..... from Trig. Mast
2. Mast & Vanes have been painted white & black respectively.
3. The station/pillar was unpiled/not unpiled/constructed on..... 19....., dimensions now being:
 - Description of mark..... should be explicit, e.g., S/Steel Pillar Plate, Steel plug, Brass plug, Bolt, G.I. Pipe
 - Height of mark.....m. ^{above}/_{below} rock/concrete; Mark is.....m. ^{above}/_{below} G.L.
 - Height of Top Vanes to Top Mark/Pillar platem. Diameter of Vanes (vertical).....m.
 - Height of Cairn.....m. Diameter of Cairn.....m. Name Plate found/not found/placed.
 - Length of Mastm. (approximate if not unpiled)
 - 4. A.....set in conc/rock has been placed/found, bearing.....° M from Mast/Plug/Pillar
 - 5. A.....set in conc/rock has been placed/found, bearing.....° M from Mast/Plug/Pillar
 - 6. A.....set in conc/rock has been placed/found, bearing.....° M from Mast/Plug/Pillar
 - 7. A.....set in conc/rock has been placed/found, bearing.....° M from Mast/Plug/Pillar
 - 8. Action required:.....

STANDPOINT:				STANDPOINT:			
Mark	Direction	Horiz. Distance	Height Difference	Mark	Direction	Horiz. Distance	Height Difference
			above standpt.				above standpt.
			below				below standpt.
			above standpt.				above standpt.
			below				below standpt.
Prepared by: D. KAIN

Noted on U.T.M. Card

Checked


2733-2 D. West, Government Printer

STATION COURTLIE (P) TS 10676

Owner's Name: Moire Plains Shire Council
 Address: Bala Street, Moree NSW 2400
 Phone: (067) 529 534

Current Occupant: Ms. Nicola Humphries
 Address:
 Phone: (067) 529 534

Access Report of/19..... was found suitable/unsuitable. ACCESS

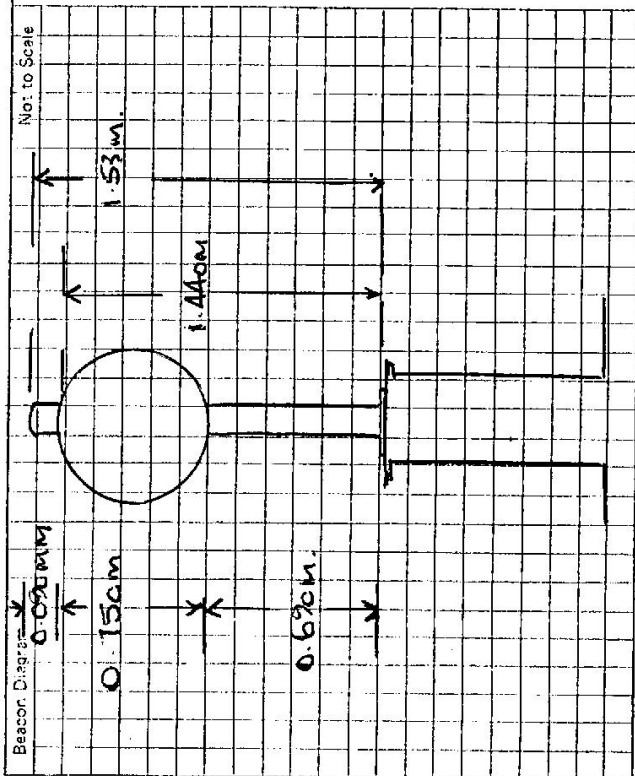

This section to be completed by officer constructing pillar.

Original station mark found/not found.

Description of mark:

Original beacon found/not found.

Description of beacon:

Height Top of Vanes to Top Markm.

Height of markm. above rock/concm. below G.L.

Diameter of Vanesm.

Original beacon has/has not been destroyed by me.

Date	Record of Station

