

Department of Lands Integrati survey of N.S.W. RECONNAISSANCE and MAINTENANCE REPORT

STATION TS 10681 BYLONG [P]
 Co: PHILLIP Ph: LEE
 Map Sheet: BYLONG No: 8933
 Inspected by: A GRAHAM Date: 15.10.79
 Authority: 15B NICLE Field Book: 1420 PDP

This Trig. Station has been:-

Note: Cross out word or words which do not apply

1. Completely cleared to permit 360° vision to surrounding Trigs. ✓
2. Cleared by ~~lines~~ bearing from Trig. Mast
3. Trig. Mast & Vanes have been painted white & black respectively. ✓
4. The Trig. was unpiled/~~not unpiled~~, dimensions now being:


Description of mark Concrete pillar should be explicit, e.g. Steel plug, Brass plug, Boli, Concrete Pillar

Height of mark m ^{above} rock/concrete 1.38 m ^{above} G.L.
 Height of Top Vanes to ~~Top mark~~ Top pillar plate 1.46 m Diameter of Vanes (vertical) 0.6 m.
 Height of Cairn 1.38 m. Diameter of Cairn .33 - .55 m.
 Length of Mast 1.55 m. (approximate if not unpiled)

5. A.....set in conc/rock has been placed/rd m. bearing°M from Trig. Mast/pillar
6. A.....set in conc/soil has been placed/rd m. bearing°M from Trig. Mast/pillar
7. A.....set in conc/soil has been placed/rd m. bearing°M from Trig. Mast/pillar
8. A.....set in conc/rock has been placed/rd m. bearing°M from Trig. Mast/pillar

9. Connection.....to..... m. bearing.....°M
10. Connection.....to..... m. bearing.....°M
11. Connection.....to..... m. bearing.....°M
12. Connection.....to..... m. bearing.....°M
13. Diff. Ht. s. m. ^{above} below
14. Diff. Ht. s. m. ^{above} below
15. Diff. Ht. s. m. ^{above} below
16. Diff. Ht. s. m. ^{above} below

Prepared by: [Signature] Checked: [Signature]

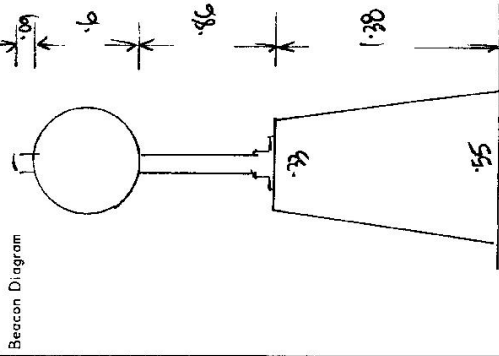


Date	Record of Station
0-7-79	Mark checked

Beacon Diagram Not to Scale

STATION TS 10681 BYLONG [P]

Owners Name: Current Occupant:

Address: Address:

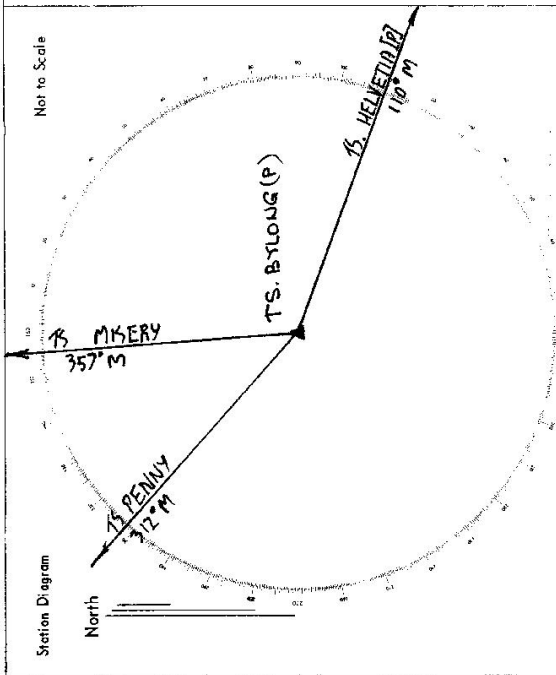

List of Observed Directions:-

Station	Direction	Station	Direction
TS HEVETIA [P]	170° 00' 00.0"		
TS 3100 PENNY	312° 20' 18.0"		
TS 3132 MISERY	356° 54' 18.5"		

Station	Direction	Station	Direction

- Access 15-10-79
- 0-0 Bylong P.O. Travel along Demman Road.
 - 0-2 Cross Bylong Ck.
 - 0-5 Turn right - take upper Bylong Rd.
 - 3-4 Causeway.
 - 3-6 Turn right through gate -
 - 3-7 to left fork.
 - 3-8 pass house on R.H.S.
 - 3-8.5 Turn right through gate.
 - 4-1 Gate
 - 4-5 Double I-Gates
 - 4-7 Turn left through Iron Gate & Wood Gate.
 - 4-8 Turn right through Iron Gate.
 - 5-3 Through double I-Gates.
 - 6-1 Take right track
 - 6-2 Pass tank on left.
 - 6-5 Trig.

Conventional vehicle to 6.2 km.

CENTRAL MAPPING AUTHORITY **NON-GEODETIC** Department of M.S.W.

GEODETIC STATION RECONNAISSANCE and MAINTENANCE REPORT

Description: *Note: Cross out word or words which do not apply*

1. Cleared by lanes bearing.....
2. Mast & Vanes have been painted white & black respectively. 79
3. The station/pillar was ~~unplaced~~ ^{unplaced} /constructed on 0.7 ~~19.5~~ m. ^{19.5} dimensions now being:
 Description of mark 4. Pillar should be explicit, e.g., S/Steel Pillar Plate, Steel plug, Brass plug, Bolt, G.I. Pipe
 Height of mark.....m. ^{above} rock/concrete; Mark is 1.35 ^{above} ~~1.35~~ m. ^{from} G.L.
 Height of Top Vanes to Top Mark/Pillar plate 1.46 m. Diameter of Vanes (vertical) 2.6 m.
 Height of Cairn 1.35 m. Diameter of Cairn.....m. Name Plate found ~~1.35~~
 Length of Mast.....m. (approximate if not unplied)
4. A..... set in conc/rock has been placed/found, bearing.....°M from Mast/Plug/Pillar
5. A..... set in conc/rock has been placed/found, bearing.....°M from Mast/Plug/Pillar
6. A..... set in conc/rock has been placed/found, bearing.....°M from Mast/Plug/Pillar
7. A..... set in conc/rock has been placed/found, bearing.....°M from Mast/Plug/Pillar
8. Action required:.....

STANDPOINT:

Mark	Direction	Horiz. Distance	Height Difference	Mark	Direction	Horiz. Distance	Height Difference
			above standpt.				above standpt.
			below				below
			above standpt.				above standpt.
			below				below
Prepared by: Abdullah 17-5-81 Checked: 17-5-81 Noted on U.T.M. Card

STATION: BYLONG T.S. No.: 510681
 MAP SHEET SCALE 1:250 000
 INSPECTED BY: P. HOLDEN DATE: 13-8-81
 AUTHORITY: CMA FIELD BOOK:

Station Diagram

716 03

Department of Lands

Integrati survey of N.S.W.
RECONNAISSANCE and MAINTENANCE REPORT

STATION TS 10681 BYLONG [P]


Co: PHILLIP Ph: LEE

Map Sheet: BYLONG No: 8933

Inspected by: A GRAHAM Date: 15.10.79

Authority: ISB NCLE Field Book: 1420 PDP

Beacon Diagram Not to Scale

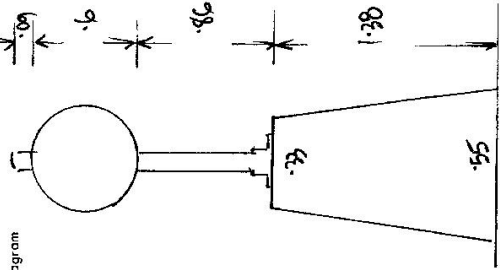

This Trig. Station has been:-

1. Completely cleared to permit 360° vision to surrounding Trigs. ✓
2. Cleared by James-bearing
3. Trig. Mast & Vanes have been painted white & black respectively. ✓
4. The Trig. was unpiled/~~not unpiled~~, dimensions now being:

Description of mark: Concrete pillar should be explicit, e.g. Steel plug, Brass plug, Bolt, Concrete Pillar

Height of mark: 1.38 m above rock/concrete 1.38 m above G.L.

Height of Top Vanes to Top Mark/Top pillar plate: 1.46 m Diameter of Vanes (vertical) 0.6 m.

Height of Cairn: 1.38 m. Diameter of Cairn: 0.33 - 0.55 m.

Length of Mast: 1.55 m. (approximate if not unpiled)

5. A. set in conc/rock has been placed/fd m. bearing°M from Trig. Mast/pillar
6. A. set in conc/soil has been placed/fd m. bearing°M from Trig. Mast/pillar
7. A. set in conc/soil has been placed/fd m. bearing°M from Trig. Mast/pillar
8. A. set in conc/rock has been placed/fd m. bearing°M from Trig. Mast/pillar

9. Connection: to m. bearing°M
10. Connection: to m. bearing°M
11. Connection: to m. bearing°M
12. Connection: to m. bearing°M
13. Diff. Ht. is m. above/below
14. Diff. Ht. is m. above/below
15. Diff. Ht. is m. above/below
16. Diff. Ht. is m. above/below


Prepared by: [Signature] Checked: [Signature]

Date	Record of Station
02/79	Mark erected.

STATION TS 10681 BYLONG (P)

Owners Name..... Current Occupant.....

Address..... Address.....

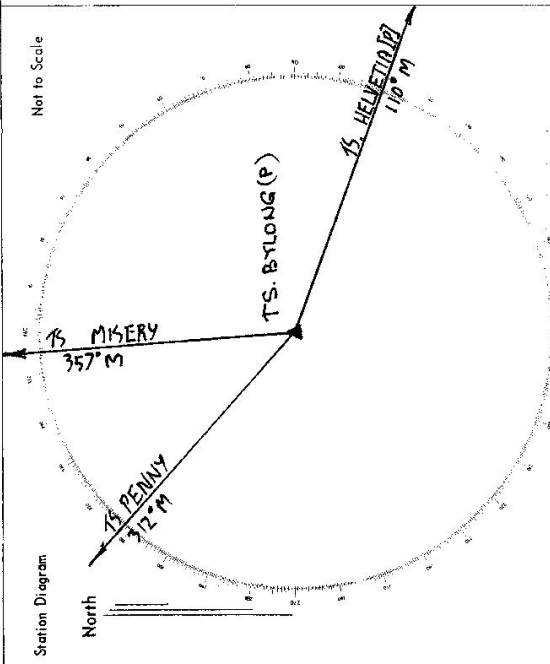

List of Observed Directions:-

Standpoint: Pillar Plate		Standpoint:	
Station	Direction	Station	Direction
TS HELVETIA (P)	110° 00' 00.0"		
TS 3100 PENNY	312° 30' 18.0"		
TS 3132 MISERY	356° 54' 18.8"		
Station	Direction	Station	Direction

- Access 15-10-79
- 0-0. Bylong P.O. Travel along Denmark Road.
 - 0-2 Cross Bylong Ck.
 - 0-5 Turn right - take Upper Bylong Rd.
 - 3-4 Causeway.
 - 3-6 Turn right through gate -
 - 3-7 on left fork.
 - 3-8 Pass house on R.H.S.
 - 3-85 Turn right through gate.
 - 4-1 Gate
 - 4-5 Double I. Gates
 - 4-7 Turn left through Iron Gate a Wood Gate.
 - 4-8 Turn right through Iron Gate.
 - 5-3 Through double I. Gates.
 - 6-1 Take right track
 - 6-2 Pass bank on left.
 - 6-5 Trig.

Conventional vehicle to 6.2 km.