

7/5/19

Department of Lands

Integral, Survey of N.S.W.

RECONNAISSANCE and MAINTENANCE REPORT

This Trig. Station has been:-

Note: Cross out word or words which do not apply

1. Completely cleared to permit 360° vision to surrounding Trigs. ✓
2. Cleared by James bearing ..... from Trig. Mast
3. Trig. Mast & Vanes have been painted white & black respectively. ✓
4. The Trig. was unpiled/~~not unpiled~~, dimensions now being:

Description of mark... Steel pillar ..... should be explicit, e.g. Steel plug, Brass plug, Bolt, Concrete Pillar  
 Height of mark ..... m above ~~below~~ rock, concrete ..... 1.25 m above G.L.  
 Height of Top Vanes to ~~Top Mark~~ Top pillar plate 1.48 ..... m Diameter of Vanes (vertical) 0.60 m.  
 Height of Cairn 1.25 ..... m. Diameter of Cairn 1.2 x 3.0 m.  
 Length of Mast 1.57 ..... m. (approximate if not unpiled)

5. A ..... set in conc./rock has been placed/fd ..... m. bearing .....°M from Trig. Mast/pillar
6. A ..... set in conc./soil has been placed/fd ..... m. bearing .....°M from Trig. Mast/pillar
7. A ..... set in conc./soil has been placed/fd ..... m. bearing .....°M from Trig. Mast/pillar
8. A ..... set in conc./rock has been placed/fd ..... m. bearing .....°M from Trig. Mast/pillar

9. Connection ..... to ..... m. bearing .....°M
10. Connection ..... to ..... m. bearing .....°M
11. Connection ..... to ..... m. bearing .....°M
12. Connection ..... to ..... m. bearing .....°M

13. Diff. Ht. .... is ..... m. above below
14. Diff. Ht. .... is ..... m. above below
15. Diff. Ht. .... is ..... m. above below
16. Diff. Ht. .... is ..... m. above below

Prepared by: celly Checked: Dijana

STATION TS 10685 THORNVALE (P)


Co: HUNTER Ph: BAERAMI

Map Sheet: KERRABEE No: 8933

Inspected by: A GERTMAN Date: 13-11-79

Authority ISB NOLE Field Book: PP132.1

Beacon Diagram

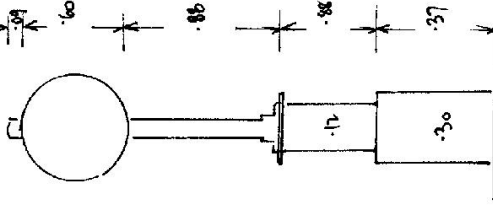

Date

Record of Station

08/11 Station Erected

STATION TS 10685 THORNVALE [P]

Owners Name... K. Worrington  
 Address of... Thornvale  
 Current Occupant... Business  
 Address...  
Via Korrabee

Access from Denman P.O. 13-11-1979  
 Km. 0.0 Korrabee.  
 0.3 Denman Co. Travel west along Ogilvie St.  
 5.7 Iron bridge over Goulburn River  
 5.9 Right turn over bridge  
 8.9 Veer right at fork (Ferndale Rd)  
 18.6 Turn left at sign "Rylstone III" "Mudree 126"  
 25.9 Pass Church on LHS.  
 26.9 through Dingo Gully  
 30.2 Turn Left through I. Gate opp. homestead.  
 Follow track with tennis court on R.H.S.

30.3 Take right track  
 30.7 Turn left before fence  
 30.8 Turn right through gate  
 30.9 Veer left away from fence - follow faint track over rocks ledges up ridge TRIG.  
 21-5

4 wheel drive ONLY.

