

715.01

Department of Lands
 RECONNAISSANCE and MAINTENANCE REPORT

-Integral Survey of N.S.W.

This Trig. Station has been:-
 Note: Cross out word or words which do not apply

1. Completely cleared to permit 360° vision to surrounding trig.
2. Cleared by lanes bearing 230° M - 45° M from Trig. Mast
3. Trig. Mast & Vanes have been painted white & black respectively. ✓
4. The Trig. was unpiled/netted, dimensions now being:

Description of mark: Steel Pillar should be explicit, e.g. Steel plug, Brass plug, Bolt, Concrete Pillar

Height of mark: 1.26 m above rock/concrete below G.L.

Height of Top Vanes to Top Mark/Top pillar plate: 1.42 m Diameter of Vanes (vertical): 0.6 m.

Height of Cairn: 1.26 m. Diameter of Cairn: 13 x 30 m.

Length of Mast: 1.51 m. (approximate if not unpiled)

5. A. set in conc./rock has been placed/fd m. bearing°M from Trig. Mast/pillar
6. A. set in conc./soil has been placed/fd m. bearing°M from Trig. Mast/pillar
7. A. set in conc./soil has been placed/fd m. bearing°M from Trig. Mast/pillar
8. A. set in conc./rock has been placed/fd m. bearing°M from Trig. Mast/pillar

9. Connection: to m. bearing°M

10. Connection: to m. bearing°M

11. Connection: to m. bearing°M

12. Connection: to m. bearing°M

13. Diff. Hr. is m. above below

14. Diff. Hr. is m. above below

15. Diff. Hr. is m. above below

16. Diff. Hr. is m. above below

Prepared by: W. G. G. G.

Checked: W. G. G. G.

STATION TS 10687 WIDDEN [P]


Co: HUNTER Ph: BARHAM

Map Sheet: VERBAACE No: 89133

Inspected by: P. M. C. BATH Date: 14-11-79

Authority: ISB NICLE Field Book: PDP 1430

Beacon Diagram Not to Scale

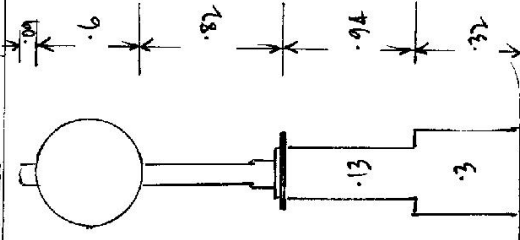

Date: _____ Record of Station

10/79 Station Erected


STATION TS 10687 WIDDEN P

Owners Name: Current Occupant:

Address: Address:

14-11-1979
 0.0 Danmon P.O. Flood wall along Ogilvie St.
 0.2 Turn left.
 0.7 Cross bridge over Goulburn River
 8.9 Veer right at fork (Ferndale Rd)
 18.6 Turn left at Sign "Rylstone III" "Mudgee 126"
 25.9 Pass church on LHS.
 26.9 Through Dingo Gully
 36.0 Turn left main "Widden Valley"
 36.05 Turn left onto track before grid.
 37.5 Turn left off track at bridge.
 37.85 Leave vehicle if 2 wheel drive.
 38.0 Follow blazed trail to trig (to south west)

About 15-20 min walk.

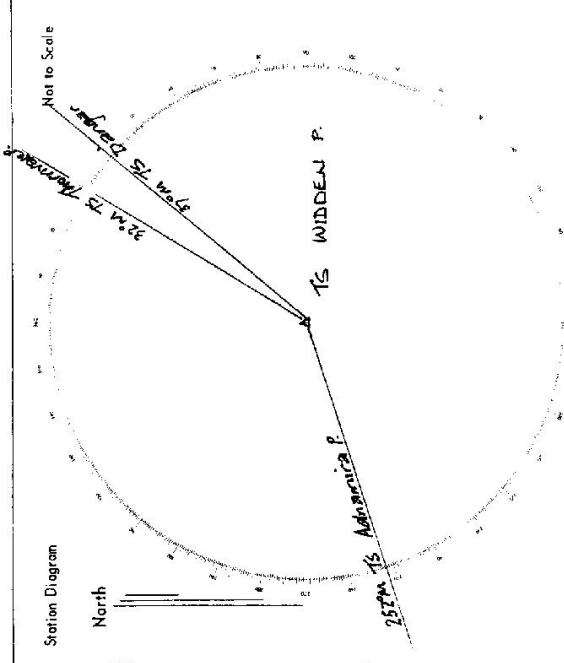

List of Observed Directions:-

Standpoint: Pillar plate		Standpoint:	
Station	Direction	Station	Direction
TS Ferndale P	32° 00' 00.0"		
TS Dangoar	37° 10' 56.3"		
TS Adnamita P	251° 56' 01.5"		