

Department of Lands

Integrated survey of N.S.W.

RECONNAISSANCE and MAINTENANCE REPORT

This Trig. Station has been:-

Note: Cross out word or words which do not apply

1. Completely cleared to permit 360° vision to surrounding Trig. ☒
2. Cleared by ~~James bearing~~ from Trig. Mast
3. Trig. Mast & Vanes have been painted white & black respectively. ☒
4. The Trig. was unpiled/~~not unpiled~~, dimensions now being:

Description of mark steel pillar should be explicit, e.g. Steel plug, Brass plug, Bolt, Concrete Pillar

Height of mark 1.19 m above rock/concrete 1.19 m above G.L.

Height of Top Vanes to ~~Top Mast~~ Top pillar plate 1.47 m Diameter of Vanes (vertical) 0.60 m.

Height of Cairn 1.19 m. Diameter of Cairn 13. x .29 m.

Length of Mast 1.57 m. (approximate if not unpiled)

5. A. B. Triangle set in ~~conc~~/rock has been placed 4.2975 m. bearing 87 °M from Trig. Mast/pillar

6. A. C.S. set in conc/~~soil~~ has been placed 4.3322 m. bearing 169 °M from Trig. Mast/pillar

7. A. set in conc/soil has been placed fd m. bearing °M from Trig. Mast/pillar

8. A. set in conc/rock has been placed fd m. bearing °M from Trig. Mast/pillar

9. Connection B. Triangle to C.S. is 4.157 m. bearing 214 °M

10. Connection to °M bearing °M

11. Connection to °M bearing °M

12. Connection to °M bearing °M

13. Diff. Ht. Pillar plate is 1.831 m. above B. Triangle

14. Diff. Ht. Pillar plate is 1.479 m. above Copper spike

15. Diff. Ht. Brass triangle is 0.352 m. above Copper spike

16. Diff. Ht. is °M above °M

Prepared by: CEB

Checked: VBH/Iman

STATION TS 10689

GOAT 107

Co: PHILLIP

Ph: MOOLARBEN

Map Sheet:

GULGONG

No: 8833

Inspected by: P. WOBERTH


Date: 4-12-79

Authority ISB NCLE

Field Book: PDP 1430

Beacon Diagram

Not to Scale

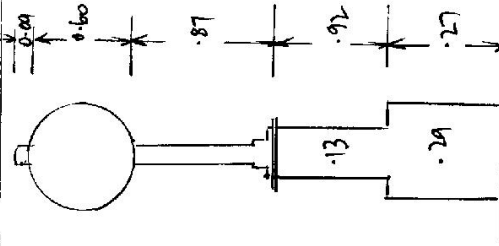

Date

Record of Station

Nov 79 Station Wrecked.

Address

Address: Langley Downs

Ullmann

Access 4 to 11.0. ULMAN P.O. Take Mudgess Road to South. Turn right into "Longly Downs" through grid.

4-3 Turn right into "Longly Downs" through grid.

4.7 I. Goh

4.75 Cross creek - turn left along tracks

5-6 Looked I. Gate (Key from House at 4.5)

6.0 Track becomes close to fence.


6.6 Right at blazes -- follow paint track.

7.15 leave vehicle.

Walk up watercourse to saddle - veer to right along ridge to TRIG.

(15 min walk.)

Conventional vehicle in dry.

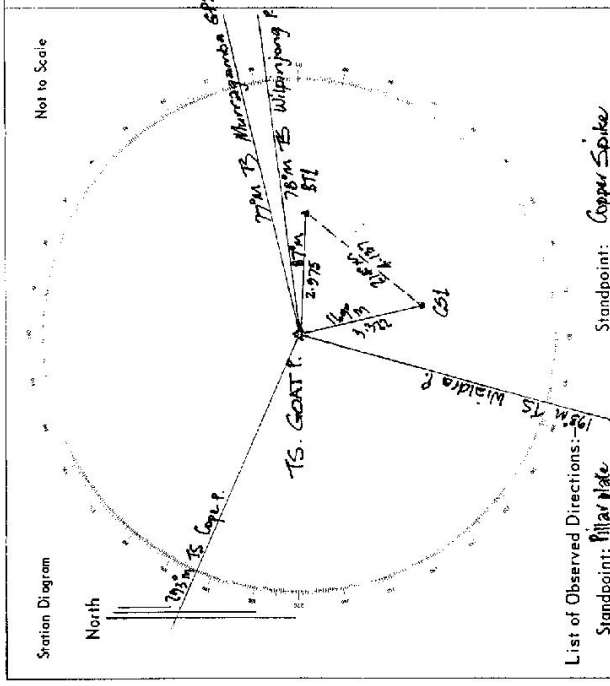

Station	Direction	Station	Direction
TS Wladra P.	195° 00' 00.0"	TS Wladra P.	0° 00' 00.0"
TS Cape P.	297° 56' 44.8"	Pillar plate	135° 57' 56.5"
TS Murragamba Gfl	77° 27' 27.2"	Brown triangle	199° 22' 44.5"
TS Wilburong P.	78° 30' 56.1"		
Brown triangle	81° 02' 21.8"		
Station	Direction	Station	Direction
Copper spike	168° 38' 50"		