

7-10-2

Department of Lands
Integral survey of N.S.W.
RECONNAISSANCE and MAINTENANCE REPORT

STATION TS 10693 WILSONDI [P]

This Trig. Station has been:

Note: Cross out word or words which do not apply

1. Completely cleared to permit 360° vision to surrounding Trigs. ✓
2. Cleared by fence-bearing..... from Trig. Mast
3. Trig. Mast & Vanes have been painted white & black respectively. ✓
4. The Trig. was unpiled/~~not~~ set, dimensions now being:

Description of mark: steel pillar..... should be explicit, e.g. Steel plug, Brass plug, Bolt, Concrete Pillar
 Height of mark..... m above rock concrete 1.46 m above G.L.
 Height of Top Vanes to Top Mark/Top pillar plate 1.465 m Diameter of Vanes (vertical) 0.6..... m.
 Height of Cairn 1.46..... m. Diameter of Cairn 13 x 26..... m.
 Length of Mast 1.555..... m. (approximate if not unpiled)

5. A..... set in conc./rock has been placed/td..... m. bearing.....°M from Trig. Mast/pillar
6. A..... set in conc./soil has been placed/td..... m. bearing.....°M from Trig. Mast/pillar
7. A..... set in conc./soil has been placed/td..... m. bearing.....°M from Trig. Mast/pillar
8. A..... set in conc./rock has been placed/td..... m. bearing.....°M from Trig. Mast/pillar

9. Connection..... to..... m. bearing.....°M
10. Connection..... to..... m. bearing.....°M
11. Connection..... to..... m. bearing.....°M
12. Connection..... to..... m. bearing.....°M
13. Diff. Ht. is..... m. ^{above}/_{below}
14. Diff. Ht. is..... m. ^{above}/_{below}
15. Diff. Ht. is..... m. ^{above}/_{below}
16. Diff. Ht. is..... m. ^{above}/_{below}

Prepared by: collg

Checked: [Signature]


Co: BOUSBAWK Ph: WICKHAM

Map Sheet: SANDY HOLLOW No: 9033

Inspected by: P. McBEATH Date: 13-11-79

Authority: ISB NICLE Field Book: PPD 1450

Beacon Diagram

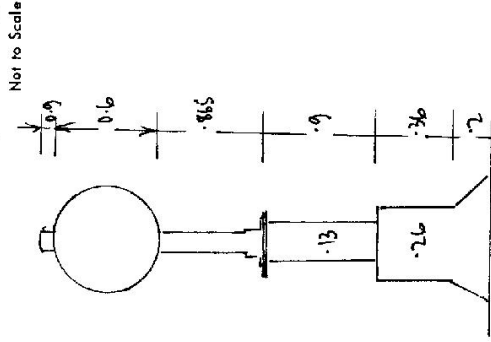

Date: 10/79 Record of Station

Station erected

STATION TS10693


WORONDI [P]

Owners Name: *Crossland*

Current Occupant:

Address:

Address:

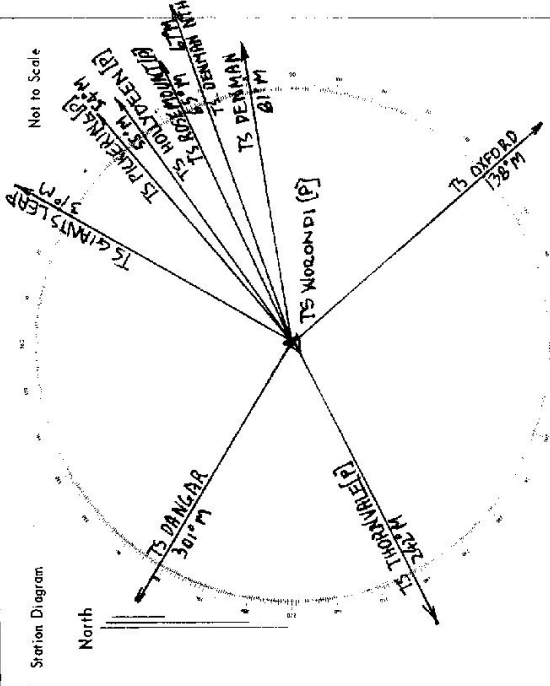

13-11-1979
 Tourist Hotel - Sandy Hollows - Follow Warrivale Rd.
 Turn left onto gravel road over grid.
 Wooden Bridge
 Railway X-ing
 Grid.
 Bus house on L.H.S.
 Grid
 Turn right off road just before grid,
 head up Westward with fence on L.H.S.
 leave vehicle at timber line and
 walk up ridge to TRIG.
 (25mins walk)

Conventional vehicle access.

List of Observed Directions:-

Station	Direction	Station	Direction
TS ROSEMOUNT [P]	15° 00' 00" 0		
TS DENMAN	60° 34' 52" 9		
TS OXFORD	137° 35' 53" 3		
TS THORNBURGH [P]	242° 22' 31" 0		
TS DANANGAR	301° 35' 24" 6		
TS HOLLYDEEN [P]	54° 42' 02" 2		
TS DENMAN NTH	67° 35' 18" 2		
TS GIANTS LEAP	30° 34' 08" 4		
TS PICKERING [P]	54° 17' 50" 4		