

1:25 0:8

Department of Lands Integrative Survey of N.S.W.
RECONNAISSANCE and MAINTENANCE REPORT

STATION **TS10694 ADNAMIRA [P]**
 Co: **BUSBAJJE** Ph: **GOULBURN**
 Map Sheet: **KERRABEE** No: **8933**
 Inspected by: **A. GRAHAM** Date: **14-11-79**
 Authority: **ISB NCLE** Field Book: **DP1321**

This Trig. Station has been:-
 Note: Cross out word or words which do not apply


1. Completely cleared to permit 360° vision to surrounding Trigs. ✓
2. Cleared by ~~lines-bearing~~ ✓ from Trig. Mast
3. Trig. Mast & Vanes have been painted white & black respectively. ✓
4. The Trig. was unpiled/~~not unpiled~~, dimensions now being:

Description of mark: **steel pillar** should be explicit, e.g. Steel plug, Brass plug, Bolt, Concrete Pillar
 Height of mark: **1.30** m above G.L.
 Height of Top Vanes to Top Mast/Top pillar plate: **1.47** m Diameter of Vanes (vertical) **0.60** m.
 Height of Cairn: **1.30** m. Diameter of Cairn **12 x 28** m.
 Length of Mast: **1.56** m. (approximate if not unpiled)

5. A. **set in conc/rock has been placed/fd** m. bearing°M from Trig. Mast/pillar
6. A. **set in conc/soil has been placed/fd** m. bearing°M from Trig. Mast/pillar
7. A. **set in conc/soil has been placed/fd** m. bearing°M from Trig. Mast/pillar
8. A. **set in conc/rock has been placed/fd** m. bearing°M from Trig. Mast/pillar

9. Connection: to m. bearing°M
10. Connection: to m. bearing°M
11. Connection: to m. bearing°M
12. Connection: to m. bearing°M
13. Diff. Ht. is m. above below
14. Diff. Ht. is m. above below
15. Diff. Ht. is m. above below
16. Diff. Ht. is m. above below

Prepared by: **colly** Checked: **Wjhm**

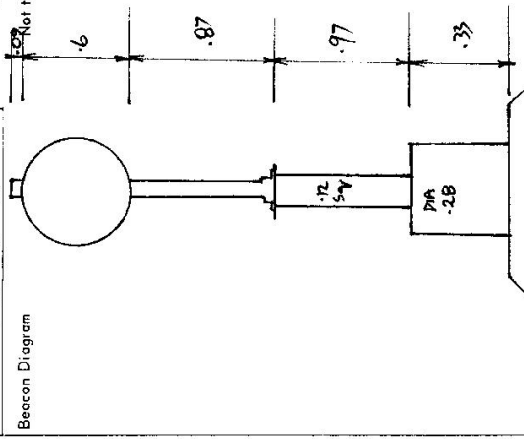

Date	Record of Station
Oct 79	Station Erected


STATION T.S. 10694 ADNAMIRA (P)

Owners Name: Greenland Current Occupant:

Address:

Access
 0-0 From Denmark P.O.
 0-3 From Denmark P.O.
 5-7 From Denmark P.O.
 5-9 From Denmark P.O.
 8-9 From Denmark P.O.
 18-6 From Denmark P.O.
 36-1 From Denmark P.O.
 36-6 From Denmark P.O.
 42-3 From Denmark P.O.
 42-65 From Denmark P.O.
 42-7 From Denmark P.O.
 42-9 From Denmark P.O.
 43-0 From Denmark P.O.
 43-4 From Denmark P.O.
 43-7 From Denmark P.O.
 44-35 From Denmark P.O.

14-11-1979
 From Denmark P.O.
 travel west along Dalvie St.
 turn left.
 Green Goulburn River
 turn right
 turn left at sign "Rylstone III" Widgee 126"
 Pass turn-off to Midden Valley.
 Cross Midden Ck.
 Causingway
 turn right - sign "Adnamira"
 cross arid - flow right through Left hand I. Gate.
 Hard left through fence opening
 Hard right down to river
 Hard left - access river - faint track veers downstream.
 Turn left along top of bank
 Turn right up small bank and make way across open
 country towards hill.
 Leave track at blazed gum near large pine tree.
 approx 1/2 hour walk up ridge to trig.
 4 wheel drive access

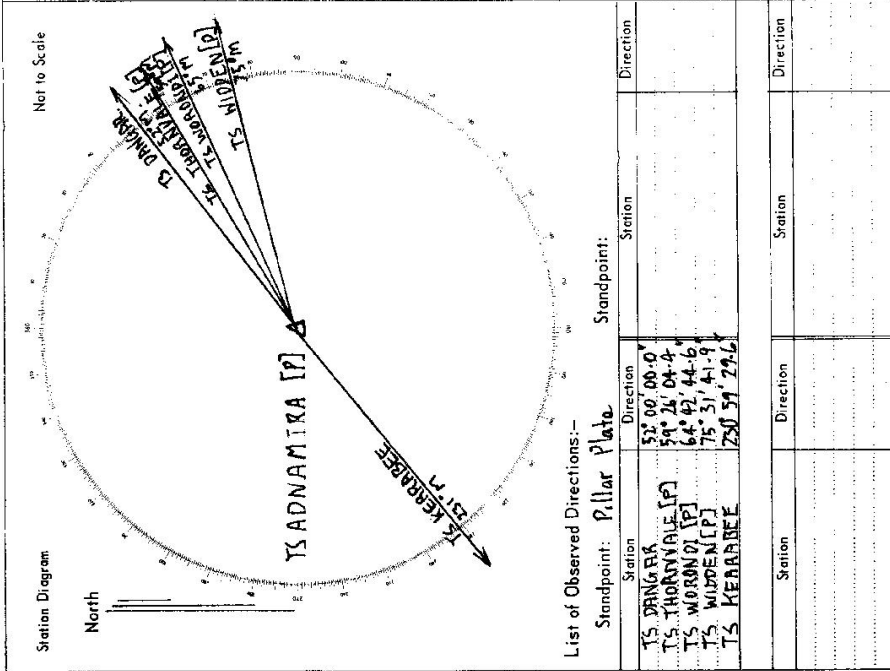

List of Observed Directions:-

Station	Direction	Station	Direction
TS DANGARR	52° 00' 00" 0	TSADNAMIRA [P]	
TS THORNVALE [P]	39° 24' 04" 4	TSADNAMIRA [P]	
TS WOODEN [P]	66° 43' 44" 6	TSADNAMIRA [P]	
TS WOODEN [P]	75° 31' 41" 9	TSADNAMIRA [P]	
TS KEARREE	730° 59' 79" 6	TSADNAMIRA [P]	