

Department of Lands Integrati Survey of N.S.W.

**RECONNAISSANCE and MAINTENANCE REPORT**

STATION **TS 10695 CLANRICHAID [P]**


Co: **BURMANE** Ph: **CLAN RICHAID**

Map Sheet: **MUSWELLBROOK** No: **9033**

Inspected by: **P. PYBETH.** Date: **15/8/79**

Authority: **I. B. NICLE** Field Book: **PDP 1320**

Beacon Diagram Not to Scale

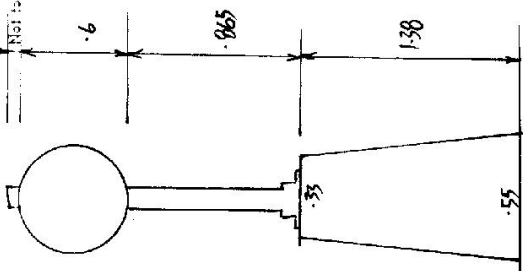

Note: Cross out word or words which do not apply

This Trig. Station has been:-

1. Completely cleared to permit 360° vision to surrounding Trigs. ✓
2. Cleared by ~~James bearing~~ from Trig. Mast
3. Trig. Mast & Vanes have been painted white & black respectively. ✓
4. The Trig. was unpiled/~~not unpiled~~, dimensions now being:
 

Description of mark: ~~concrete pillar~~ should be explicit, e.g. Steel plug, Brass plug, Bolt, Concrete Pillar

Height of mark: ~~1.38~~ m <sup>above</sup> ~~rock/concrete~~ 1.38 m above G.L.

Height of Top Vanes to ~~Top Mark~~/Top pillar plate: ~~1.465~~ m Diameter of Vanes (vertical): **0.60** m.

Height of Cairn: ~~1.38~~ m. Diameter of Cairn: **0.33 x 0.55** m.

Length of Mast: ~~1.555~~ m. (approximate if not unpiled)
5. A.....set in conc/rock has been placed/fd .....m. bearing.....°M from Trig. Mast/pillar
6. A.....set in conc/soil has been placed/fd .....m. bearing.....°M from Trig. Mast/pillar
7. A.....set in conc/soil has been placed/fd .....m. bearing.....°M from Trig. Mast/pillar
8. A.....set in conc/rock has been placed/fd .....m. bearing.....°M from Trig. Mast/pillar
9. Connection.....to.....m. bearing.....°M
10. Connection.....to.....m. bearing.....°M
11. Connection.....to.....m. bearing.....°M
12. Connection.....to.....m. bearing.....°M
13. Diff. Ht. .... is.....m. <sup>above</sup> ~~below~~
14. Diff. Ht. .... is.....m. <sup>above</sup> ~~below~~
15. Diff. Ht. .... is.....m. <sup>above</sup> ~~below~~
16. Diff. Ht. .... is.....m. <sup>above</sup> ~~below~~

Prepared by: *[Signature]* Checked: *[Signature]*

Beacon Diagram

Date: **Aug 79** Record of Station

**Station Erected**

STATION TS 10695 CLANRICARD [P]

Owners Name *Mrs. Atkers* Current Occupant *Burman*

Address *Radcliffe* Address

*via Muswellbrook*  
from Muswellbrook.

- Access 15-8-1979  
80 kms Muswellbrook P.O. Take Hwy north towards Scene.  
1-15 Left off Hwy towards Sandy Hollow.  
2-05 Right over bridge  
2-90 Take Sandy Hollow turn-off to left.  
5-00 Pass Logues Lane on LHS  
5-95 Left at Bengalla Rd.  
6-85 Follow bitumen to right  
7-75 Grid  
7-80 Right angle bend  
8-2 Grid  
8-8 "  
9-6 "  
13-7 Turn left through iron gate just before railway crossing  
14-2 make way across paddocks to rig.

2-IND ACCESS

