

7.5 10.3

Department of Lands

Integrative Survey of N.S.W.
RECONNAISSANCE and MAINTENANCE REPORT

STATION TS 10696

ROXBURGH D

This Trig. Station has been:-

Note: Cross out word or words which do not apply

1. Completely cleared to permit 360° vision to surrounding Trigs. ✓
2. Cleared by Jones-bearing ✓
3. Trig. Mast & Vanes have been painted white & black respectively. ✓
4. The Trig. was unpiled/~~not unpiled~~, dimensions now being:
Description of mark: Concrete pillar should be explicit, e.g. Steel plug, Brass plug, Balr, Concrete Pillar
Height of mark: 1.38 m ^{above} rock, concrete 1.38 m ^{above} G.L.

5. A 1.55 m. Diameter of Cairn 33 x .55 m.
Length of Mast 1.55 m. (approximate if not unpiled)
6. A 1.38 m. bearing 0 M from Trig. Mast/pillar
7. A 1.38 m. bearing 0 M from Trig. Mast/pillar
8. A 1.38 m. bearing 0 M from Trig. Mast/pillar


9. Connection to: m. bearing M
10. Connection to: m. bearing M
11. Connection to: m. bearing M
12. Connection to: m. bearing M
13. Diff. Ht. is m. ^{above} below
14. Diff. Ht. is m. ^{above} below
15. Diff. Ht. is m. ^{above} below
16. Diff. Ht. is m. ^{above} below

Prepared by: [Signature] Checked: [Signature]

Co: WISDAM
Map Sheet: MURWILLBROOK
Inspected by: P. MCBATH
Authority: IS B NCLE

Ph: CLAWREARD
No: 9033
Date: 15.8.79
Field Book: DDP1323

Beacon Diagram

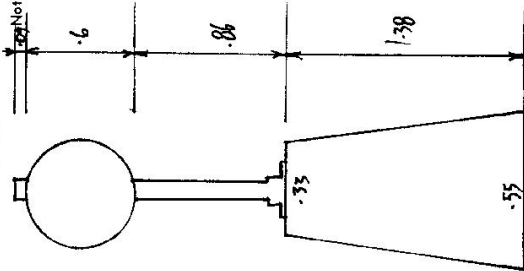

Date	Record of Station
<u>Aug 21</u>	<u>Station Erected.</u>

STATION TS 10696 KOX BURGH P

Owners Name... P.T.C. Current Occupant.....

Address.....

- Access from Denman. 15.8.1919
- 0.0. Denman - take Sandy Hollow Rd
 - 2-3 Turn right before Railway X-ing
 - Sign - Mangoola Rd.
 - 3-9 Railway X-ing
 - 5.6 Right turn.
 - 7.0 Left turn after Railway X-ing
 - 9.3 Left turn over Railway X-ing
 - 12.0 Turn right.
 - 13.8 Right onto gravel road.
 - 14.1 Left through I. Gale - sign "Craigend"
 - 14.3 Through old yards.
 - 14.5 TRIG.

Conventional Vehicle Access.

