


STATION TS10697 MANGOOLA [P]

Owners Name: Public Road Current Occupant:

Address:

15-8-1979
 Access From Denman.
 0.0. Denman - take Sandy Hollow Rd.
 2.3 Turn Right before Railway X-ing
 Sign Mangoola Rd.
 3.0 Railway X-ing
 4.8 TRIG on side of Road.

Vehicle
 Conventional Access.

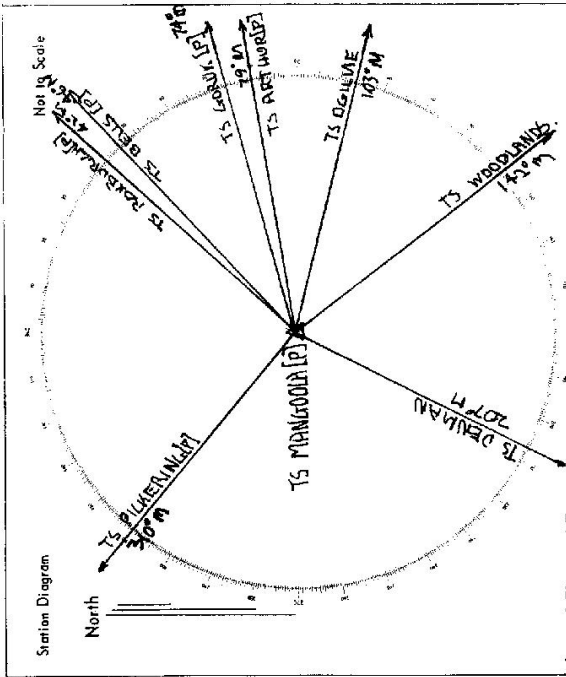

List of Observed Directions:-

Standpoint: Pillar Data.		Standpoint:	
Station	Direction	Station	Direction
TS MANGOOLA (P)	42° 00' 00.0"	TS PICKERING (P)	300° 00' 00.0"
TS BELL (P)	45° 45' 45.2"	TS DENMAN	207° 00' 00.0"
TS GOROK (P)	74° 21' 26.7"	TS WOODLANDS	142° 01' 19.8"
TS ARTHUR (P)	78° 57' 45.2"	TS OGILVIE	107° 00' 00.0"
TS OGILVIE	102° 55' 25.2"	TS SANDY HOLLOW	19° 00' 00.0"
TS WOODLANDS	142° 01' 19.8"	TS ARTHUR (P)	19° 00' 00.0"
TS DENMAN	207° 00' 00.0"	TS MANGOOLA (P)	42° 00' 00.0"
TS PICKERING (P)	300° 00' 00.0"		