

7.5.103

Department of Lands Integrati survey of N.S.W.
RECONNAISSANCE and MAINTENANCE REPORT

STATION **TS 10698 MURRAGAMBA (P)**
 Co: **PHILLIP** Ph: **WILPINJONG**
 Map Sheet: **GULGONG** No: **8833**
 Inspected by: **P. McBlath** Date: **14.11.79**
 Authority **ISB No. LE** Field Book: **D.P. 1430**

This Trig. Station has been:- Note: Cross out word or words which do not apply

1. Completely cleared to permit 360° vision to surrounding Trigs. ✓
2. Cleared by ~~James-bearing~~ from Trig. Mast
3. Trig. Mast & Vanes have been painted white & black respectively. ✓
4. The Trig. was unpiled/~~not-emptied~~, dimensions now being:


Description of mark... ~~concrete pillar~~ should be explicit, e.g. Steel plug, Brass plug, Bolt, Concrete Pillar
 Height of mark... ~~1.375~~ m above ~~rock~~/^{concrete} 1.375 m above G.L.
 Height of Top Vanes to Top Mark/Top pillar plate... ~~1.47~~ m Diameter of Vanes (vertical)... ~~0.6~~ m.
 Height of Centre... m. Diameter of Centre... m.

Length of Mast... m. (approximate if not supplied)
 5. A. ~~G.I. Pipe~~ set in ~~concrete~~/^{soil} has been placed/~~to~~ ~~3.249~~ m. bearing... ~~283~~ °M from Trig. ~~Mast~~/^{pillar}
 6. A. ~~C.S.~~ set in conc/~~soil~~ has been placed/~~to~~ ~~5.164~~ m. bearing... ~~321~~ °M from Trig. ~~Mast~~/^{pillar}
 7. A. set in conc/soil has been placed/~~to~~ m. bearing... °M from Trig. Mast/pillar

8. A. set in conc/rock has been placed/~~to~~ m. bearing... °M from Trig. Mast/pillar
 9. Connection ~~G.I.P.~~ to ~~Pillar~~ ~~3.249~~ m. bearing... ~~103~~ °M
 10. Connection ~~G.I.P.~~ to ~~C.S.I.~~ ~~3.305~~ m. bearing... ~~179~~ °M

11. Connection... to... m. bearing... °M
 12. Connection... to... m. bearing... °M
 13. Diff. Ht. ~~Pillar~~ Plate is ~~1.491~~ m. ^{above} ~~G.I. PIPE~~
 14. Diff. Ht. ~~Pillar~~ Plate is ~~1.432~~ m. ^{above} ~~Copper Spike~~
 15. Diff. Ht. ~~G.I. PIPE~~ is ~~0.059~~ m. ^{above} ~~Copper Spike~~
 16. Diff. Ht. is m. ^{above} ~~below~~

Prepared by: *[Signature]* Checked: *[Signature]*

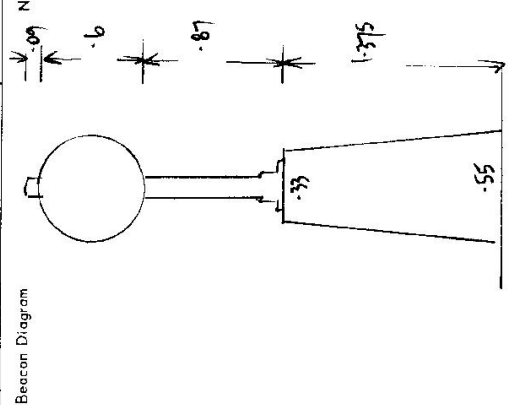

Date	Record of Station
Dec 79	Mark created

STATION SIDES MURRAGAMBA IP1

Current Occupant: Owner

Owners Name: L. ROBINSON

Address: GREENWOOD

Address:

VLAN

- Access 14-12-1979
- 0-0. U/LN. Take Mudque road to south.
 - 0-7 Turn left onto gravel road.
 - 1-5 Iron Gate.
 - 2-0 Left through fence opening
 - 2-2 Cross wooden bridge - care required
 - 3-3 Pass sheds on R/S - then through gate.
 - 3-4 fence opening - turn left.
 - 3-45 Creek crossing
 - 3-6 fence opening
 - 3-65 " "
 - 3-85 Iron Gate.
 - 4-4 Leave fence.
 - 4-95 Take left track
 - 5-5 TRIG.

Conventional vehicle in dry.

