


7/10

Department of Lands  
 STATION TS 10701  
 Co: **BALRANIE** Ph: **DENHAM**  
 Map Sheet: **SANDY HOLLOW** No: **9033**  
 Inspected by: **A. GRATHAM** Date: **13-11-79**  
 Authority: **ISB NOLE** Field Book: **1320**

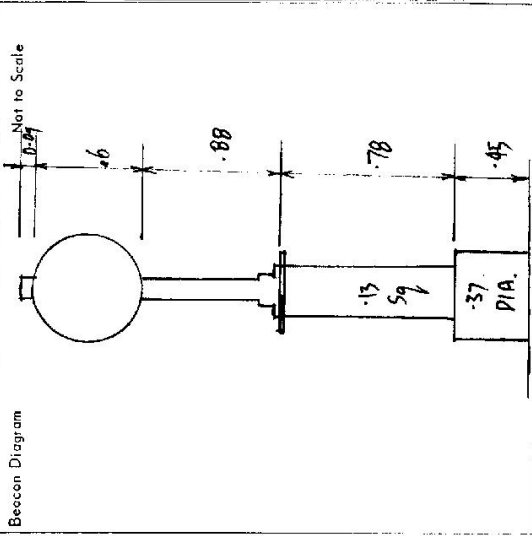

Date: **Aug 79** Record of Station  
**Station Erected**

Integral survey of N.S.W.  
 RECONNAISSANCE and MAINTENANCE REPORT

This Trig. Station has been:-  
 Note: Cross out word or words which do not apply

1. Completely cleared to permit 360° view to surrounding Trigs.
2. Cleared by lanes bearing 89°M - 350°M from Trig. Mast
3. Trig. Mast & Vanes have been painted white & black respectively. ✓
4. The Trig. was unpiled, ~~re-erected~~, dimensions now being:

Description of mark: **steel pillar** should be explicit, e.g. Steel plug, Brass plug, Bolt, Concrete Pillar

Height of mark: <sup>above</sup> 1.23 m <sup>below</sup> rock, concrete <sup>above</sup> G.L.

Height of Top Vanes to Top Mark: Tap pillar plate 1.48 m Diameter of Vanes (vertical) 0.60 m.

Height of Cairn 1.23 m Diameter of Cairn 13.437 m.

Length of Mast 1.57 m. (approximate if not unpiled)

5. A. set in conc./rock has been placed/rd .....m. bearing .....°M from Trig. Mast/pillar
6. A. set in conc./soil has been placed/rd .....m. bearing .....°M from Trig. Mast/pillar
7. A. set in conc./soil has been placed/rd .....m. bearing .....°M from Trig. Mast/pillar
8. A. set in conc./rock has been placed/rd .....m. bearing .....°M from Trig. Mast/pillar
9. Connection to .....m. bearing .....°M
10. Connection to .....m. bearing .....°M
11. Connection to .....m. bearing .....°M
12. Connection to .....m. bearing .....°M
13. Diff. Ht. is .....m. <sup>above</sup> <sup>below</sup>
14. Diff. Ht. is .....m. <sup>above</sup> <sup>below</sup>
15. Diff. Ht. is .....m. <sup>above</sup> <sup>below</sup>
16. Diff. Ht. is .....m. <sup>above</sup> <sup>below</sup>

Prepared by: **AGD** Checked: **WJH**

STATION TS 10701 ROSEMOUNT [P]

Current Occupant... DWYER

Owners Name... T. CLARKE

Address of Rosemount...  
 U3 Denman

Access 13-11-1979  
 0.0. Denman... take Sandy Hollow Road.  
 7-8 Turn left - Sign Rosemount Winery  
 10-8 Turn left through I. Gate opp yards  
 Approx 100m. before cottage on West side of road.  
 Make way up to timber line.  
 11-0 Leave vehicle  
 15min walk up through rocks to TRIG.

Conventional vehicle access.

