

14192

Department of Lands Integral Survey of N S W
RECONNAISSANCE and MAINTENANCE REPORT

This Trig. Station has been:- Note: Cross out word or words which do not apply

- ✓ 1. Completely cleared to permit 360° vision to surrounding Trigs.
- 2. Cleared by lanes bearing from Trig. Mast
- 3. Trig. Mast & Vanes have been painted white & black respectively.
- 4. The Trig. was unpiled/~~not unpiled~~, dimensions now being:
 - Description of mark... ~~STEEL PILE~~ ~~CONC~~ ~~CONC~~ should be explicit, e.g. Steel plug, Brass plug, Ball, Concrete Pillar
 - Height of mark m ^{above} ~~rock~~ ~~concrete~~ m ^{below} G.L.

Height of Top Vanes to Top-Mark/Top pillar plate m Diameter of Vanes (vertical) m.
 Height of Cairn m. Diameter of Cairn m.

Length of Mast m. (approximate if not unpiled)

5. A ~~CONCRETE~~ ~~STONE~~ set in conc/~~rock~~ has been placed/ft ~~10.817~~ m. bearing ~~58~~° M from Trig. ~~Mast~~/pillar

6. A ~~PM20649~~ set in conc/~~soil~~ has been placed/ft ~~8.079~~ m. bearing ~~87~~° M from Trig. ~~Mast~~/pillar


7. A set in conc./soil has been placed/ft m. bearing° M from Trig. Mast/pillar

8. A set in conc./rock has been placed/ft m. bearing° M from Trig. Mast/pillar

9. Connection ~~Corner to~~ ~~STONE~~ ~~PM20649~~ ~~5.429~~ m. bearing ~~192~~° M
10. Connection to m. bearing° M
11. Connection to m. bearing° M
12. Connection to m. bearing° M
13. Diff. Ht. ~~Corner~~ ~~STONE~~ is ~~1.981~~ m. ^{below} ~~STONE~~ ~~PILLAR~~ ~~CURTAIN~~
14. Diff. Ht. ~~PM20649~~ is ~~1.655~~ m. ^{below} ~~STONE~~ ~~PILLAR~~ ~~CURTAIN~~
15. Diff. Ht. is m. ^{above} ~~STONE~~ ~~PILLAR~~ ~~CURTAIN~~
16. Diff. Ht. is m. ^{below} ~~STONE~~ ~~PILLAR~~ ~~CURTAIN~~

Prepared by: C. STARKEY Checked: L. HAYES


STATION TS 10704 CARNES (P)
 Co: CUMBERLAND Pr: MUNTO
 Map Sheet: LIVERPOOL 1-25000 No: 9030-11-S
 Inspected by: C. STARKEY Date: 29-1-80
 Authority: DEPT LANDS Field Book: 7157

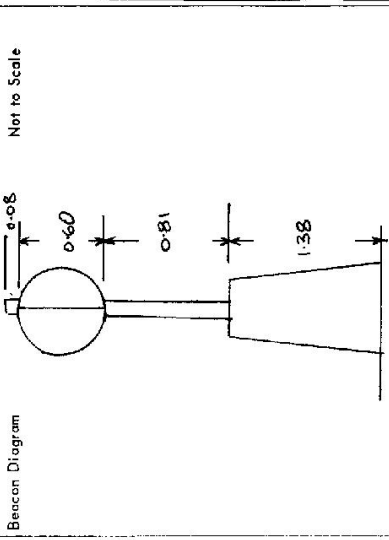

Date	Record of Station
14/12/19	PILLAR ERECTED - R. HANMILL


STATION TS10704 CARNIES

Owners Name: Planning & Environment Commission
 Address: PITT ST SYDNEY
 Current Occupant:
 Address:

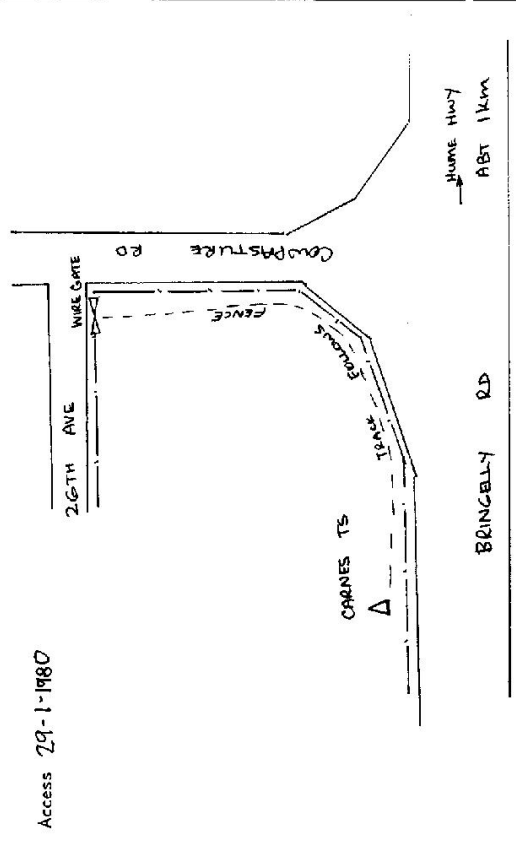

Access 29-1-1980

D. West, Government Printer, New South Wales - 1976

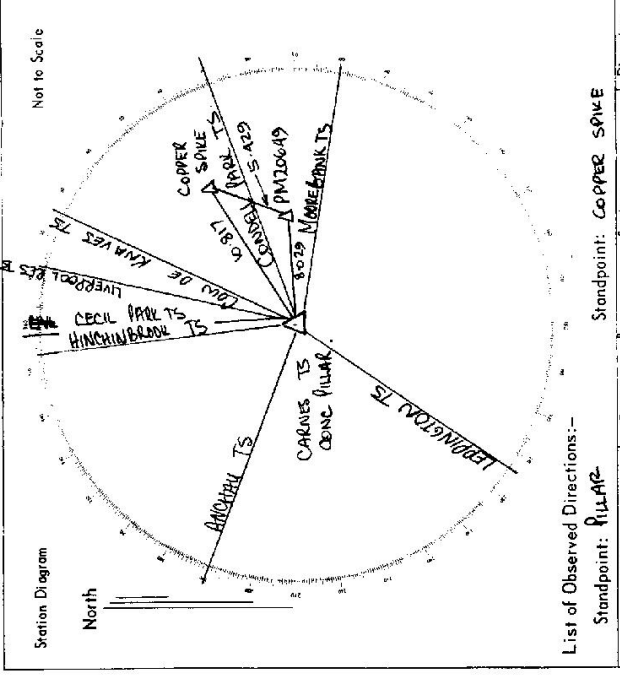

List of Observed Directions:-
 Standpoint: PILLAR

Station	Direction	Station	Direction
COW DE KINVER TS	75 00 00	RMSY RES TS	0 00 00
CONDELL PARK TS	70 43 28.2	P.M. 20649	20 10 15
HARRISMAN TS	100 03 04.8	PILLAR	65 52 20
LEPPINGTON TS	214 44 13.1		
HINCHINBROOK TS	353 21 42.8		
CECIL PARK TS	357 10 34.8		
LIVERPOOL RES TS	14 38 16.7		
ANCHRAH TS	290 23 43.2		
COPPER SPIKE	58 15 43.2		
P.M. 20649	87 17 23.7		