

7.5-19.9

Department of Lands  
 Reconnaissance and MAINTENANCE REPORT  
 Integrals Survey of N.S.W.

This Trig. Station has been: Not to scale  
 Note: Cross out word or words which do not apply

STATION TS 10705 TAMBOOR HOPPER (P)

Co: CAMDEN Ph: BARGO

Map Sheet: BARGO No: 9029-111-N

Inspected by: J. KWASNICA Date: 14 JULY '80

Authority: INTEGRATION SURVEYS Field Book: 1A96/13

Beacon Diagram

1. Completely cleared to permit 360° vision to surrounding Trigs. ✓

2. ~~Cleared by fenes-bearing~~ ..... from Trig. Mast

3. ~~Trig. Mast & Vanes have been painted white & black respectively~~

4. ~~The Trig. was unspited/not unspited, dimensions now being~~ .....  
 Description of mark: Brass. A. in Conc. Roof should be explicit, e.g. Steel plug, Brass plug, Bolt, Concrete Pillar

Height of mark: ..... m <sup>above</sup> rock/concrete ..... m <sub>below</sub> G.L.

Height of Top Vanes to Top Mark/Top pillar plate: ..... m Diameter of Vanes (vertical) ..... m.

Height of Cairn: ..... m. Diameter of Cairn: ..... m.

Length of Mast: ..... m. (approximate if not unspited)

5. A. ~~set in conc/rock has been placed/fd~~ ..... m. bearing ..... °M from Trig. Mast/pillar

6. A. ~~set in conc/soil has been placed/fd~~ ..... m. bearing ..... °M from Trig. Mast/pillar

7. A. ~~set in conc/soil has been placed/fd~~ ..... m. bearing ..... °M from Trig. Mast/pillar

8. A. ~~set in conc/rock has been placed/fd~~ ..... m. bearing ..... °M from Trig. Mast/pillar

9. Connection: ..... to ..... m. bearing ..... °M

10. Connection: ..... to ..... m. bearing ..... °M

11. Connection: ..... to ..... m. bearing ..... °M

12. Connection: ..... to ..... m. bearing ..... °M

13. Diff. Ht. ..... is ..... m. <sup>above</sup> <sub>below</sub>

14. Diff. Ht. ..... is ..... m. <sup>above</sup> <sub>below</sub>

15. Diff. Ht. ..... is ..... m. <sup>above</sup> <sub>below</sub>

16. Diff. Ht. ..... is ..... m. <sup>above</sup> <sub>below</sub>

Prepared by: W. Skewton Checked: R. Cullen

Date	Record of Station

No BEACON ERECTED.

STATION TS 10705 TAHMOOR HOPPER (P)

Owners Name: **COALTRIA MINES**

Address: .....


Current Occupant: .....

Address: .....

Access **14-7-1980**

Not to Scale

Station Diagram  
North  
**COAL HOPPER**

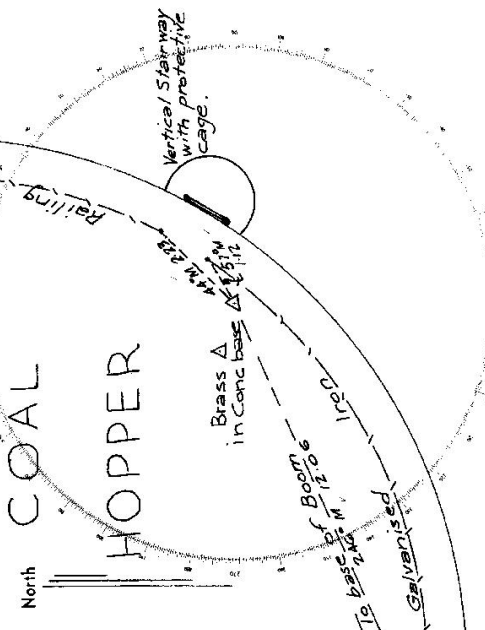


List of Observed Directions:-

Station	Direction	Station	Direction
TS 2912 (LILPION)	190 00 00	TS 10194 (TAH COLLIER)	130 57 07
TS 10706 (STILTON)	171 06 37B		
TS 10112 (DOUGLAS PL)	71 20 15'		
TS 10022 (TAH ALUMIN)	88 50 03		
TS 10112 (COBERUX COAL)	190 52 00		

Standpoint: **Beats A**

Station	Direction	Station	Direction

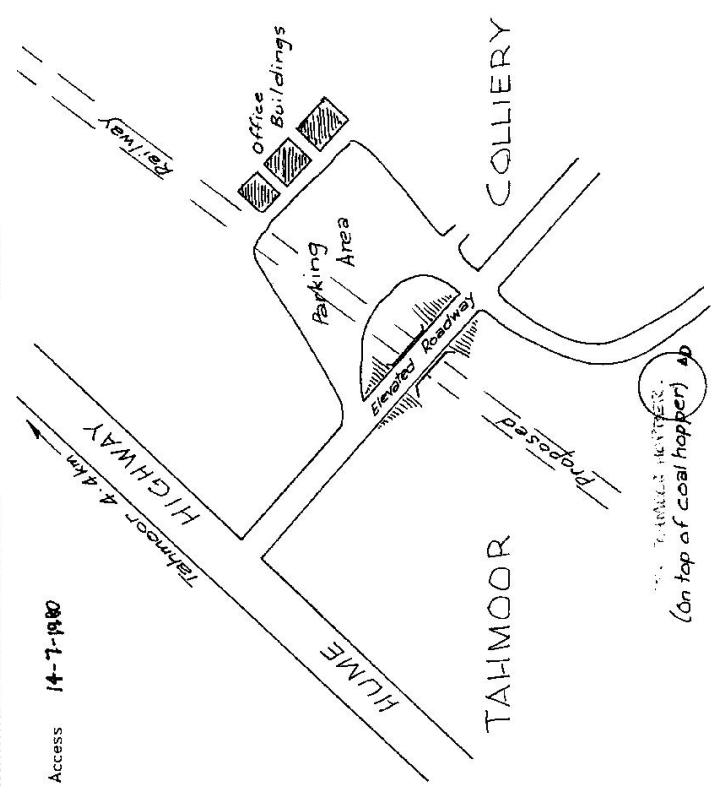

(On top of coal hopper) **AD**