


Department of Lands
 Integral Survey of N.S.W.
 RECONNAISSANCE and MAINTENANCE REPORT
 STATION TS 10707, EMBER MDS (1)
 Co: CAMDEN
 Ph: SUTTON FOREST
 Map Sheet: MOSS VALE
 No: 8528-1-1-N
 Inspected by: P. HAIRCORNBE
 Date: 31-3-80
 Authority: ~~LANDS~~ ~~DEPARTMENT~~ ~~OF~~ ~~LANDS~~
 Field Book: ~~TS/10707~~



Date	Record of Station
	Steel Pile, P. 1.30 m. Cit. Beacon
	PLATE ON BEACON CITEROUS BEACON

- This Trig. Station has been:-
- Note: Cross out word or words which do not apply
1. Completely cleared to permit 360° vision to surrounding Trigs.
 2. Cleared by lones bearing GREY from Trig. Mast
 3. Trig. Mast & Vanes have been painted ~~white~~ ~~black~~ respectively.
 4. The Trig. was unpiled/~~re-erected~~, dimensions now being:
 - Description of mark: STEEL PILLAR should be explicit, e.g. Steel plug, Brass plug, Bolt, Concrete Pillar
 - Height of mark: 1.30 m ^{above} ~~below~~ steel platform 7 m (approx) above G.L.
 - Height of Top Vanes to ~~Top~~ Top pillar plate: 2.515 m Diameter of Vanes (vertical)..... m.
 - Height of Cairn..... m. Diameter of Cairn..... m.
 5. A Steel Plug ~~set in concrete~~ has been placed /fd 45.656m. bearing 211.....°M from Trig. ~~Mast~~ /pillar
 6. A Trig. Plug ~~set in concrete~~ has been placed /fd 54.513 m. bearing 212.....°M from Trig. ~~Mast~~ /pillar
 7. A SA Pipe ~~set in conc~~ ^{UMR} has been placed /fd 48.916 m. bearing 212.....°M from Trig. ~~Mast~~ /pillar
 8. A Steel Plug ~~set in concrete~~ has been placed /fd 28.666m. bearing 218.....°M from Trig. ~~Mast~~ /pillar
 9. Connection..... to..... m. bearing.....°M
 10. Connection..... to..... m. bearing.....°M
 11. Connection..... to..... m. bearing.....°M
 12. Connection..... to..... m. bearing.....°M
 13. Diff. Ht. is..... m. ^{above} ~~below~~
 14. Diff. Ht. is..... m. ^{above} ~~below~~
 15. Diff. Ht. is..... m. ^{above} ~~below~~
 16. Diff. Ht. is..... m. ^{above} ~~below~~
- Prepared by: P. Haircornbe Checked: P. Haircornbe 14/8/80

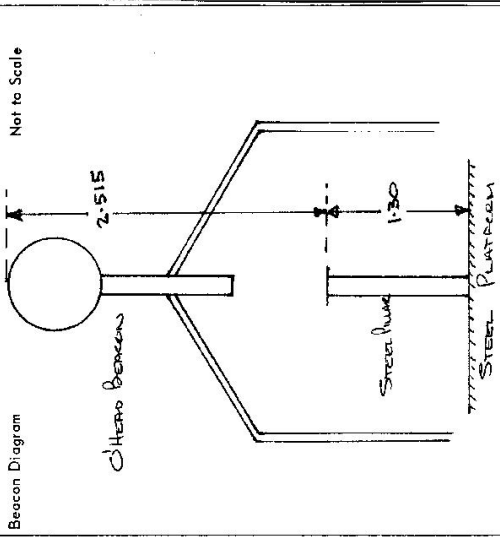