

7.6.19.3

Department of Lands

Integrative Survey of N.S.W.
RECONNAISSANCE and MAINTENANCE REPORT


This Trig. Station has been:

Note: Cross out word or words which do not apply

1. Completely cleared to permit 360° vision to surrounding Trigs. ✓
2. Cleared by lances bearing from Trig. Mast
3. Trig. Mast & Vanes have been painted white & black respectively. ✓
4. The Trig. was unpiled/not unpiled, dimensions now being:
Description of mark..... **CONCRETE PILLAR** should be explicit, e.g. Steel plug, Brass plug, Bolt, Concrete Pillar
Height of mark..... m ^{above} rock/concrete m ^{below} G.L.
Height of Top Vanes to Top-Mast/Top pillar plate m Diameter of Vanes (vertical) 0.6 m.
Height of Cairn..... m. Diameter of Cairn..... m.
Length of Mast 1.565 m. (approximate if not unpiled)
5. A. ~~SSM 36683~~ set in conc./~~rock~~ has been placed/td **8.803** m, bearing **243** °M from Trig. Mast/pillar
6. A. **C.S.** set in conc./~~rock~~ has been placed/td **7.341** m, bearing **341** °M from Trig. Mast/pillar
7. A. **G.I. Pipe** set in ~~conc/soil~~ has been placed/td **7.610** m, bearing **251** °M from Trig. Mast/pillar
8. A. set in conc./rock has been placed/td m, bearing °M from Trig. Mast/pillar
9. Connection..... to..... m, bearing..... °M
10. Connection..... to..... m, bearing..... °M
11. Connection..... to..... m, bearing..... °M
12. Connection..... to..... m, bearing..... °M
13. Diff. Ht. **Pillar plate** is **1.33** m. ^{above} **SSM 36682**
14. Diff. Ht. **Pillar plate** is **1.63** m. ^{above} **C.S.**
15. Diff. Ht. **SSM 36683** is **0.3** m. ^{above} **C.S.**
16. Diff. Ht. is m. ^{above} **SSM 36682**

Prepared by: P. Maguire Checked: [Signature]

STATION **TS 10709 (WHITTINGHAM [P])**
 Co: **DURHAM** | Ph: **WHITTINGHAM**
 Map Sheet: **SINGLETON** | No: **9132-IV-N**
 Inspected by: **A. GRAHAM** | Date: **7.10.80**
 Authority: **I.S.D. NEWCASTLE** | Field Book: **FD 1507/57**
 1508/57 1509/1
 Not to Scale
 Beacon Diagram

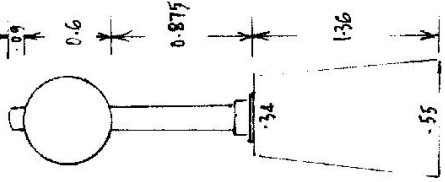

Date	Record of Station
Sept 80	After treated (new station - no old mark)

