

7.5.10.2

Department of Lands Integrating Survey of N.S.W.  
**RECONNAISSANCE and MAINTENANCE REPORT**

This Trig. Station has been: Note: Cross out word or words which do not apply

1. Completely cleared to permit 360° vision to surrounding Trigs. ✓
2. Cleared by James bearing from Trig. Mast
3. Trig. Mast & Vanes have been painted white & black respectively. ✓
4. The Trig. was unpiled/~~not unpiled~~, dimensions now being: 0.60 x 0.60 should be explicit, e.g. Steel plug, Brass plug, Bolt, Concrete Pillar

Description of mark concrete pillar m. above rock/concrete m. below G.L.

Height of Top Vanes to Top-Mark/Top pillar plate 1.47 m Diameter of Vanes (vertical) 0.60 m.

Height of Cairn 1.36 m. Diameter of Cairn 33 x 55 m.

Length of Mast 1.56 m. (approximate if not unpiled)

5. A CS1 set in conc/~~rock~~ has been placed/at 18.25 m. bearing 167°M from Trig. Mast/pillar

6. A CS2 set in conc/~~soil~~ has been placed/at 8.17 m. bearing 240°M from Trig. Mast/pillar

7. A CS2 set in conc/~~soil~~ has been placed/at m. bearing °M from Trig. Mast/pillar

8. A CS1 set in conc/~~rock~~ has been placed/at m. bearing °M from Trig. Mast/pillar

9. Connection CS1 to CS2 17.300 m. bearing 323°M

10. Connection CS1 to CS2 17.300 m. bearing 323°M

11. Connection CS1 to CS2 17.300 m. bearing 323°M

12. Connection CS1 to CS2 17.300 m. bearing 323°M

13. Diff. Hr. Pillar Plate is 1.051 m. above CS1


14. Diff. Hr. Pillar Plate is 1.175 m. above CS2

15. Diff. Hr. CS1 is 0.128 m. above CS2

16. Diff. Hr. CS1 is 0.128 m. above CS2

Prepared by: [Signature] Checked: MCB

STATION TS 10712 (NENDELL [P])  
 Co: DURHAM | Pk: LIDDELL  
 Map Sheet: CAMBORWELL | No: 9193-111-S  
 Inspected by: A GRAHAM | Date: 10.9.80  
 Authority: ISB NOLE | Field Book: 1509 PDP

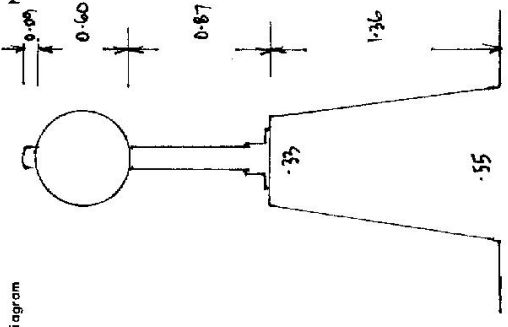

Beacon Diagram


Date	Record of Station
Sept 80	Pillar erected

STATION TS 10712 (NEWDELL (P))

Owners Name: P.T.C. Current Occupant: P.T.C.

Address: SYDNEY

Access 10-9-1980  
 00 Km. Singleton - New England Hwy to Muswellbrook  
 22.8 Right into Liddell Coll.  
 22.98 " through I. Gade just over bridge  
 23.1 Right fork.  
 23.35 TS.

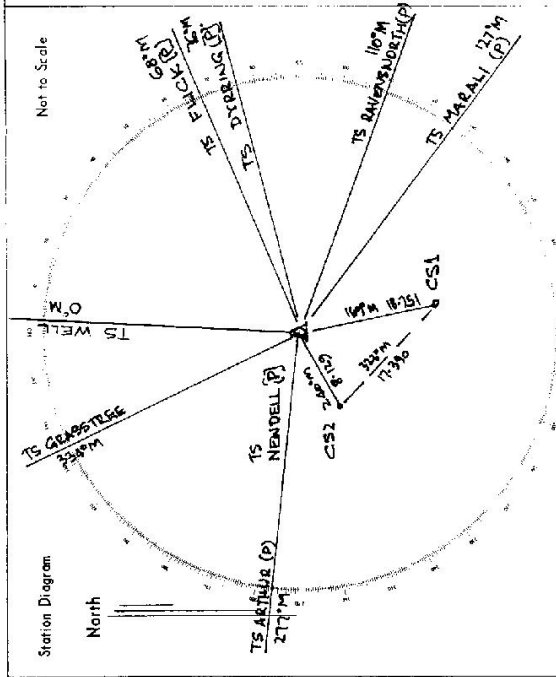

List of Observed Directions:-

Station	Direction	Station	Direction
TS WELL	3° 00' 32"	TS NEWDELL (P)	0° 00' 00"
TS FLICK (P)	71° 01' 07"	CSI	333° 46' 10"
TS DYRRING (P)	79° 07' 00"		
TS RAVENSWORTH (P)	112° 55' 07"		
TS MARALLI (P)	126° 46' 35"		
CSI			
CSI	168° 51' 28"		
CSI	239° 49' 51"		
TS ARTHUR (P)	280° 23' 38"		

Conventional vehicle access.