




STATIONS 10717 BADGERY

Owners Name: I.S. & D. McKay  
 Current Occupant: ...  
 Address: Collingwood  
 Via: Exeter  
 Access: 1-5-1980

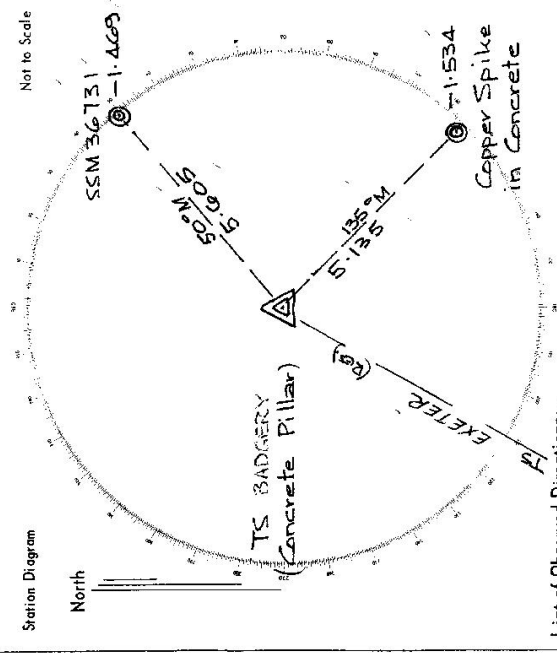


List of Observed Directions:-

Station	Direction	Station	Direction
TS EXETER RES	0700 00	TS EXETER RES	0700 00
SSM 36731	181 30 21	PILLAR PLATE	7 29 55
COPPER SPIKE	268 50 44	COPPER SPIKE	321 04 58

Standpoint: Pillar Plate Standpoint: SSM 36731

Station	Direction	Station	Direction

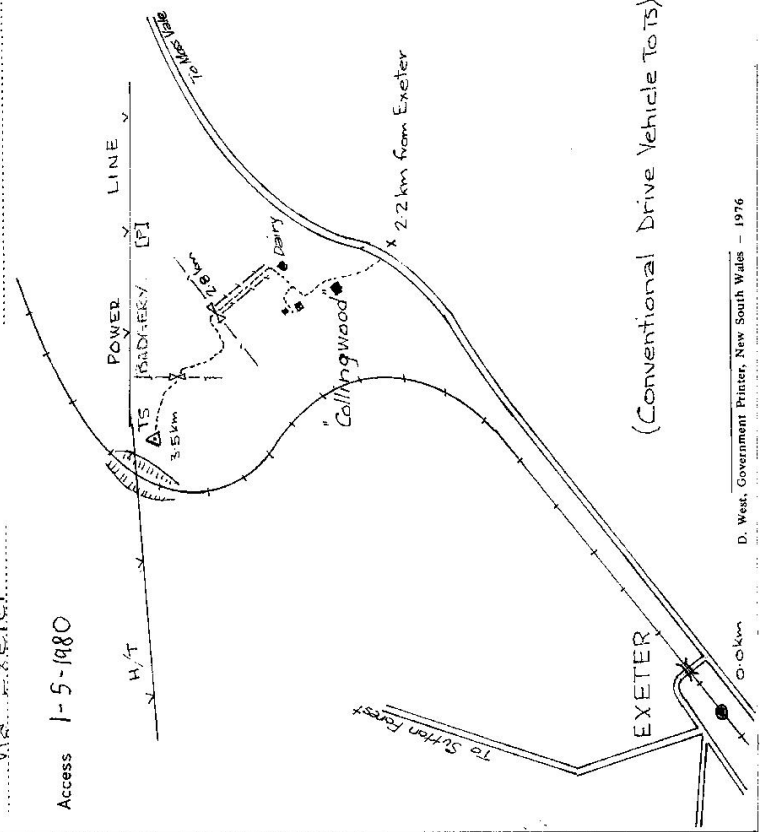

D. West, Government Printer, New South Wales - 1976