


STATION TS 10722 Broughton (P)
 Co: CAMDEN Ph: BONG BONG
 Map Sheet: MOSS VALE No: 8528-1-N
 Inspected by: H. G. HELSHAM Date: 30-4-80
 Authority: INTEGRATION SURVEYS Field Book: 1472/10
 Beacon Diagram Not to Scale

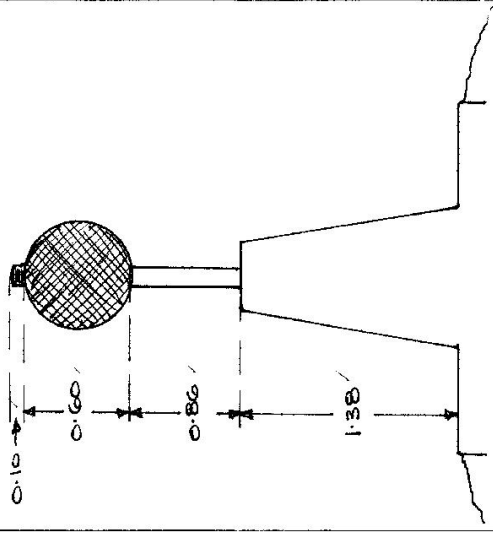

Date	Record of Station

Department of Lands Integral Survey of N.S.W.
 RECONNAISSANCE and MAINTENANCE REPORT

This Trig. Station has been: *Note: Cross out word or words which do not apply*

1. Completely cleared to permit 360° vision to surrounding Trigs. ✓
2. Cleared by ~~lines-bearing~~ ✓ from Trig. Mast
3. Trig. Mast & Vanes have been painted white & black respectively. ✓
4. ~~The Trig. was supplied, not supplied, dimensions now being:~~

Description of mark: **CONCRETE PILLAR** should be explicit, e.g. Steel plug, Brass plug, Bolt, Concrete Pillar
 Height of mark: ~~1.38~~ ^{1.38} m ~~above~~ ^{below} ~~rock~~ ^{G.L.} concrete
 Height of Top Vanes to Top-Mark/Top pillar plate: ~~1.45~~ m Diameter of Vanes (vertical): ~~0.60~~ m.
 Height of Conn: m Diameter of Cap: m.


- Length of Mast: ~~1.50~~ ^{SSM} m. (approximate if not supplied)
5. A. ~~3.0735~~ ^{SSM} set in conc/rock has been placed/fd ~~3.065~~ m. bearing ^{3.8} °M from Trig. Mast/pillar
 6. A. ~~Copper Spike~~ set in conc/~~soil~~ has been placed/fd ~~5.004~~ m. bearing ^{15.5} °M from Trig. Mast/pillar
 7. A. set in conc/soil has been placed/fd m. bearing °M from Trig. Mast/pillar
 8. A. set in conc/rock has been placed/fd m. bearing °M from Trig. Mast/pillar
 9. Connection: ~~3.0735~~ ^{SSM} to ~~Spike~~ ^{Copper}: ~~7.115~~ m. bearing ² °M
 10. Connection: to : m. bearing °M
 11. Connection: to : m. bearing °M
 12. Connection: to : m. bearing °M
 13. Diff. Ht. ~~Rivar Plate~~ is ~~1.150~~ ^{SSM} m. ~~above~~ ^{SSM 30735}
 14. Diff. Ht. ~~Pillar Plate~~ is ~~1.632~~ ^{SSM} m. ~~above~~ ^{Copper Spike}
 15. Diff. Ht. is m. ~~above~~
 16. Diff. Ht. is m. ~~above~~

Prepared by: Walter Stewart Checked: Murdoch 14/8/80

STATIONTS 10722 BROUGHTON(V)

Owners Name.....
 Current Occupant.....
 Address.....
 Address.....

MOSS VALE
 Access 30~4-80
 Scale 1:31680
 Conventional Drive Vehicle
 To T.S.

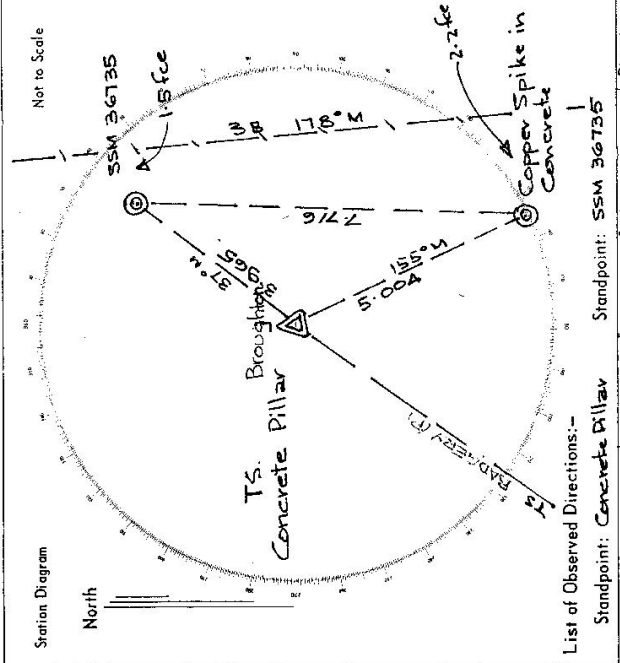

List of Observed Directions:-

Station	Direction	Station	Direction
TS 1501 (FEZ/77)	0° 00' 00"	TS Broughton (P)	0° 00' 00"
SSM 36735	181 45 24	Pillar Plate	1 44 19
Copper Spike in Conc	299 54 30	Copper Spike in Conc	326 51 50

