

GEODETTIC SURVEY OF A.S.I.K.

CENTRAL MAPPING AUTHORITY

GEODETTIC STATION RECONNAISSANCE and MAINTENANCE REPORT

Description:

1. Cleared by ~~toner-bearing~~ full 360° ~~from T. Rig, Mast~~ from T. Rig, Mast

2. Mast & Vanes have been painted white & black respectively.

3. The station/pillar was ~~erected~~ not unpiled/constructed on 18th February 1989, dimensions now being:

Description of mark: ~~Steel Pillar~~ Steel Pillar Plate, e.g., S/Steel Pillar Plate, Steel plug, Brass plug, Bolt, G.I. Pipe

Height of mark: 1.65 m. ~~above rock/concrete~~ above G.L.

Height of Top Vanes to Top Mast/Pillar plate 1.47 m. Diameter of Vanes (vertical) 0.160 m.

Height of Cairn: 1.50 m. Diameter of Cairn: 0.15 m. Name Plate found/~~not found~~ placed.

Length of Mast: 1.50 m. (approximate if not unpiled)

4. A Brass Rod set in conc/rock has been ~~placed~~ found, bearing 62.0° M from Mast/Plug/Pillar 3.558 m dist

5. A Brass A. Plug set in conc/rock has been ~~placed~~ found, bearing 166.0° M from Mast/Plug/Pillar 0.786 m dist

6. A G.I. Pipe set in conc/rock has been ~~placed~~ found, bearing 326.0° M from Mast/Plug/Pillar 4.100 m dist

7. A Brass Rod set in conc/rock has been ~~placed~~ found, bearing 166.0° M from Mast/Plug/Pillar

8. Action required: Paint Pillar Mast & Vanes

STANDPOINT:

Mark	Direction	Horiz. Distance	Height Difference	Mark	Direction	Horiz. Distance	Height Difference
			above standpt				above standpt
			below standpt				below standpt
			above standpt				above standpt
			below standpt				below standpt
STANDPOINT:


Mark	Direction	Horiz. Distance	Height Difference	Mark	Direction	Horiz. Distance	Height Difference
			above standpt				above standpt
			below standpt				below standpt
			above standpt				above standpt
			below standpt				below standpt
Prepared by: J. S. S. S. S.

Checked: J. S. S. S. S.

Named on U.T.M. Card

Checked

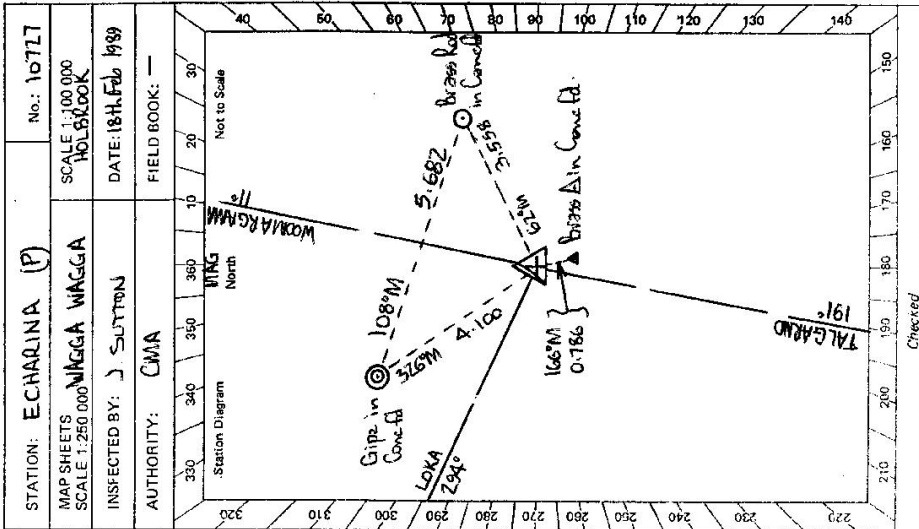


STATION **ECHARINA (P) TS 10727**

Owner's Name **Bernard Hore**
 Address **"Echarina" Echarina Road**
Via Mullengandra
 Phone:

Current Occupant: **DWARF**
 Address:

ACCESS
 Access Report of **12.6.1988** was found suitable **for construction**

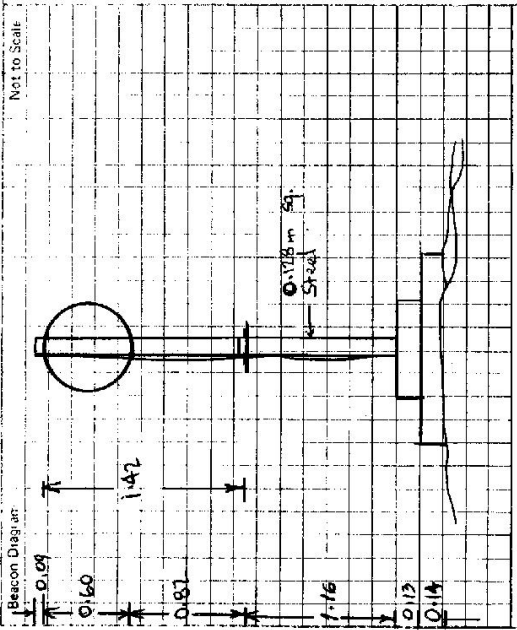

This section to be completed by officer constructing pillar.

Original station mark found/not found.

Description of mark:

Original beacon found/not found.

Description of beacon:

Height Top of Vanes to Top Markm

Height of mark.....m. above G.L. below

Diameter of Vanesm. Height of Cairnm.

Original Beacon has/has not been destroyed by me.

Date	Record of Station

